

SURVEY & REMONUMENTATION

STATE OF MICHIGAN
COUNTY OF KENT
RECEIVED FOR RECORD

APR 28 1995

LAND CORNER RECORDATION CERTIFICATE
Filing Requirement of Act 74, Mich. P.A. 1970

DEC 29 AM 11:12

For corners in

COMMISSION

KENT COUNTY REMONUMENTATION

Kent (County)	Located in:	Corner Code #
1. Public Land Survey	T <u>7N</u> R <u>11W</u>	<u>D-9</u>
	T _____ R _____	_____
	T _____ R _____	_____
	T _____ R _____	_____
2. Property Controlling in Section	S _____ T _____ R _____	_____
	S _____ T _____ R _____	_____
3. Miscellaneous Property in Sec.	S _____ T _____ R _____	_____
	S _____ T _____ R _____	_____


W. J. Bond
REG. OF DEEDS

7935

Register of Deeds Stamp & File Number

4. Lot No. _____, Recorded Plat _____
5. Private Claims _____

I, Randy Kolehouse, in a field survey on November 2 19 94, do hereby certify that under requirements of P.A. 74 Michigan P.A. of 1970, the corner points mentioned in lines 1 and 2 above were in conformance with regulations and rules therefore as required in the current manual of survey instructions of the United States Department of the interior, Bureau of Land Management or by a decree of a Court of Law and/or that the corner points mentioned in lines 3, 4 and 5 above were in conformance with the rules of the Michigan Board of Land Surveyors or by a Decree of a Court of Law; established, re-established, monumented, re-monumented, recovered, found as expressed below:

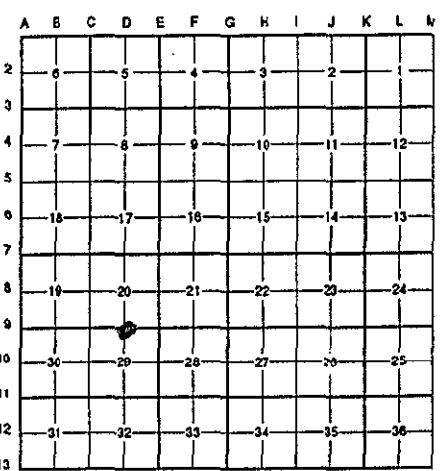

NOTE: Not more than 4 corners, all in the same town and range, may be recorded on this certificate.

A. Description of original monument and accessories and/or subsequent restoration:

D-9	1817	G.L.O. Notes	Mullett	Set Post
	1930	Survey Records	K.C. Surveyor	Spike in Pavement
	N/A	Survey Records	City of Grand Rapids	City Iron in Mon. Box
	1978	L.C.R.C. #1333	William R. Byl	City Iron in Mon. Box
	1982	L.C.R.C. #2759	Williams & Works	City Iron in Mon. Box
	1988	L.C.R.C. #4591	Bueche	Set 3" Riser over City Iron

Statement: Williams & Works 3/3/82 L.C.R.C. #2759

B. Description of corner evidence found and/or method applied in restoring or reestablishing corner:

D-9 This corner has been destroyed by recent construction by the City of Grand Rapids along with all witnesses shown on L.C.R.C.'s #2759 and #4591. Reestablished corner using Williams & Works survey records.


P.A. 345 1990 KENT COUNTY
PEER APPROVED 11/3/94
CHAIRMAN *Harry Hubert*

The selected location is accepted by me and is generally accepted by professional surveyors as the best available evidence of the position of the original corner.

C. Description of monument for corner and accessories established to perpetuate locating the position of the corner:

D-9 Set 1/2" x 24" rebar with cap stamped "Kent County Remon." in concrete pavement.

- Nail & K.C. remon. tag in SE side p. pole N 65° E 74.30'
- Chiseled "+" in top bolt to conc. sign base S 40° E 81.34'
- Chiseled "+" in top East bolt to conc. sign base S 45° W 63.35'
- Chiseled "+" in conc. gutter N 45° W 47.03' (prop. corner)
- Top East bolt on conc. base for roof overhang support N 35° W 68.86'

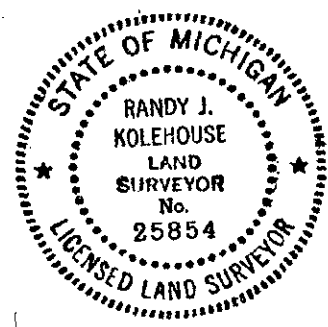

Signed by *Randy J. Kolehouse* Date 12/20/94
Surveyor's Michigan License No. 25854