

SURVEY & REMONUMENTATION

APR 28 1995

COMMISSION LAND CORNER RECORDATION CERTIFICATE Filing Requirement of Act 74, Mich. P.A. 1970 KENT COUNTY REMONUMENTATION

For corners in

Kent <small>(County)</small>	Located in:	Corner Code #
1. Public Land Survey	T <u>7N</u> R <u>11W</u>	<u>D-12</u>
	T _____ R _____	_____
	T _____ R _____	_____
	T _____ R _____	_____
2. Property Controlling in Section	S _____ T _____ R _____	_____
	S _____ T _____ R _____	_____
3. Miscellaneous Property in Sec.	S _____ T _____ R _____	_____
	S _____ T _____ R _____	_____

4. Lot No. _____, Recorded Plat _____
5. Private Claims _____

STATE OF MICHIGAN
COUNTY OF KENT
RECEIVED FOR RECORD

94 DEC 29 AM 11:12

W. J. Bond
REG. OF DEEDS

7953

Register of Deeds Stamp & File Number

I, Randy Kolehouse, in a field survey on September 29 19 94, do hereby certify that under requirements of P.A. 74 Michigan P.A. of 1970, the corner points mentioned in lines 1 and 2 above were in conformance with regulations and rules therefore as required in the current manual of survey instructions of the United States Department of the Interior, Bureau of Land Management or by a decree of a Court of Law and/or that the corner points mentioned in lines 3, 4 and 5 above were in conformance with the rules of the Michigan Board of Land Surveyors or by a Decree of a Court of Law; established, re-established, monumented, re-monumented, recovered, found as expressed below:

NOTE: Not more than 4 corners, all in the same town and range, may be recorded on this certificate.

A. Description of original monument and accessories and/or subsequent restoration:

D-12 This corner was not originally set by the G.L.O.

1930's Survey Records Williams & Works City Iron

B. Description of corner evidence found and/or method applied in restoring or reestablishing corner:

D-12 Set point using intersection of cuts on M.H. rim at the C/L intersection of Franklin Street running E-W and Fuller Avenue running N-S which checks street improvements. Also checks distance to East 1/4 as shown in Williams & Works 1930's survey within 1.0' and distance to South 1/4 within 0.5'. Point is on N-S 1/4 line and 6.4' South of E-W 1/4 line. Accepted as Center Section.


P.A. 345 1990 KENT COUNTY
PEER APPROVED 11/3/94
CHAIRMAN *Randy Kolehouse*

The selected location is accepted by me and is generally accepted by professional surveyors as the best available evidence of the position of the original corner.

C. Description of monument for corner and accessories established to perpetuate locating the position of the corner:

D-12 Intersection of rim cuts on M.H.

- Nail & K.C. remon. tag in E side p. pole N 15° E 172.14'
- Nail & K.C. remon. tag in N side p. pole S 70° E 111.56'
- Nail & K.C. remon. tag in NE side 12" Maple S 20° E 96.84'
- Nail & K.C. remon. tag in NW side p. pole S 45° W 41.10'
- Nail & K.C. remon. tag in SW side p. pole N 30° W 42.86'

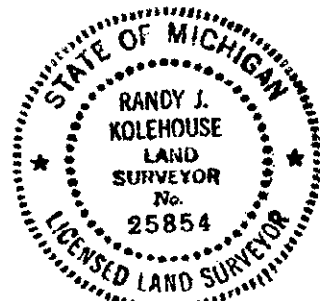

Signed by *Randy J. Kolehouse* Date 12/12/94
Surveyor's Michigan License No. 25854

