

SURVEY & REMONUMENTATION

APR 28 1995

COMMISSION

LAND CORNER RECORDATION CERTIFICATE
 Filing Requirement of Act 74, Mich. P.A. 1970
 KENT COUNTY REMONUMENTATION

STATE OF MICHIGAN
 COUNTY OF KENT
 RECEIVED FOR RECORD

94 DEC 29 AM 11:12

Tim J. Bond
 REG. OF DEEDS


For corners in

<u>Kent</u> (County)	Located in:	Corner Code #
1. Public Land Survey	T <u>7N</u> R <u>11W</u>	<u>E-1</u>
	T _____ R _____	_____
	T _____ R _____	_____
	T _____ R _____	_____
2. Property Controlling in Section	S _____ T _____ R _____	_____
	S _____ T _____ R _____	_____
3. Miscellaneous Property in Sec.	S _____ T _____ R _____	_____
	S _____ T _____ R _____	_____

7941

Register of Deeds Stamp & File Number

4. Lot No. _____, Recorded Plat _____
 5. Private Claims _____

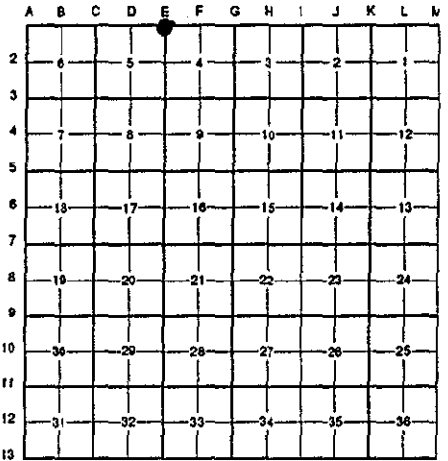

I, Randy Kolehouse, in a field survey on July 5 19 94, do hereby certify that under requirements of P.A. 74 Michigan P.A. of 1970, the corner points mentioned in lines 1 and 2 above were in conformance with regulations and rules therefore as required in the current manual of survey instructions of the United States Department of the Interior, Bureau of Land Management or by a decree of a Court of Law and/or that the corner points mentioned in lines 3, 4 and 5 above were in conformance with the rules of the Michigan Board of Land Surveyors or by a Decree of a Court of Law; established, re-established, monumented, re-monumented, recovered, found as expressed below:

NOTE: Not more than 4 corners, all in the same town and range, may be recorded on this certificate.

A. Description of original monument and accessories and/or subsequent restoration:

E-1	1831	G.L.O. Notes	L. Lyon	Set Post
	1937	Wit. Map	K.C. Surveyor	3/4" Iron
	1971	L.C.R.C. #62	Williams & Works	1" Iron in Mon. Box
	1978	L.C.R.C. #1144	Exxel Engineering	1" Iron in Mon. Box
	1981	L.C.R.C. #1792	Williams & Works	1" Mon. in M.B./Set K.C. Mon.

This corner was originally approved by the Kent County Remonumentation Peer Group monumented by John A. Merdzinski on 1/23/81 and was recorded per L.C.R.C. #1792.

B. Description of corner evidence found and/or method applied in restoring or reestablishing corner:

E-1 Found standard Kent County Monument in 4 Mile Road running E-W per L.C.R.C. #1792 as set by Williams & Works in place of a 1" iron in a monument box they found which checked L.C.R.C.'s #229 and #1144.

L.C.R.C. #1792

- NE cor. brick building S 46° W 78.18'
- NE cor. CB N 05° E 22.17'
- Nail & K.C. remon. tag NW side 10" Maple N 35° E 72.71'
- Nail & K.C. remon. tag NW side 12" Maple N 55° E 93.93'
- Nail & K.C. remon. tag NE side p. pole N 75° W 114.59'
- On C/L 4 Mile Road (E-W)
- C/L Plainfield (N-S) 500' ± West

P.A. 345 1990 KENT COUNTY
 PEER APPROVED 11/3/94
 CHAIRMAN *Harry Huber*

The selected location is accepted by me and is generally accepted by professional surveyors as the best available evidence of the position of the original corner.

C. Description of monument for corner and accessories established to perpetuate locating the position of the corner:

- E-1 Standard Kent County Monument
- NE cor. brick building S 46° W 78.18'
 - NE cor. CB N 05° E 22.17'
 - Nail & K.C. remon. tag NW side 10" Maple N 35° E 72.71'
 - Nail & K.C. remon. tag NW side 12" Maple N 55° E 93.93'
 - Nail & K.C. remon. tag NE side p. pole N 75° W 114.59'
 - Nail & K.C. remon. tag S side p. pole S 70° W 59.04'
 - On C/L 4 Mile Road (E-W)
 - C/L Plainfield (N-S) 500' ± West



Signed by Randy J. Kolehouse
 Surveyor's Michigan License No. 25854

Date 12/12/94