

SURVEY & REMONUMENTATION

APR 28 1995

LAND CORNER RECORDATION CERTIFICATE
Filing Requirement of Act 74, Mich. P.A. 1970
KENT COUNTY REMONUMENTATION

STATE OF MICHIGAN
COUNTY OF KENT
RECEIVED FOR RECORD

94 DEC -6 AM 9:02

For corners in

COMMISSION

Kent (County)	Located in:	Corner Code #	
1. Public Land Survey	T <u>7N</u> R <u>11W</u>	<u>F-1</u>	
	T _____ R _____	_____	
	T _____ R _____	_____	
	T _____ R _____	_____	
2. Property Controlling in Section	S _____ T _____ R _____	_____	
	S _____ T _____ R _____	_____	
3. Miscellaneous Property in Sec.	S _____ T _____ R _____	_____	
	S _____ T _____ R _____	_____	

Lucy Bond
REG. OF DEEDS

7802

Register of Deeds Stamp & File Number

4. Lot No. _____, Recorded Plat _____
5. Private Claims _____

	A	B	C	D	E	F	G	H	I	J	K	L	M
2	6	5	4	3	2	1							
3													
4	7	8	9	10	11	12							
5													
6	18	17	16	15	14	13							
7													
8	19	20	21	22	23	24							
9													
10	30	29	28	27	26	25							
11													
12	31	32	33	34	35	36							
13													

I, Randy Kolehouse, in a field survey on July 5 19 94, do hereby certify that under requirements of P.A. 74 Michigan P.A. of 1970, the corner points mentioned in lines 1 and 2 above were in conformance with regulations and rules therefore as required in the current manual of survey instructions of the United States Department of the Interior, Bureau of Land Management or by a decree of a Court of Law and/or that the corner points mentioned in lines 3, 4 and 5 above were in conformance with the rules of the Michigan Board of Land Surveyors or by a Decree of a Court of Law; established, re-established, monumented, re-monumented, recovered, found as expressed below:

NOTE: Not more than 4 corners, all in the same town and range, may be recorded on this certificate.

A. Description of original monument and accessories and/or subsequent restoration:

F-1 This corner was not originally set by the G.L.O.
 1965 Wit. Maps K.C. Surveyor Iron
 1972 L.C.R.C. #229 Williams & Works Iron in Mon. Box
 1981 L.C.R.C. #1791 Williams & Works Fnd. Iron in Mon. Box/Set K.C. Mon.

This corner was originally approved by the Kent County Remonumentation Peer Group and monumented by Williams & Works on 1/26/81 and was recorded per L.C.R.C. #1791.

B. Description of corner evidence found and/or method applied in restoring or reestablishing corner:

F-1 Found standard Kent County Monument in the C/L of 4 Mile Road running E-W and Vineyard Avenue running South per L.C.R.C. #1791 as set by Williams & Works in place of a 1/2" iron in monument box they found which checked K.C. Surveyor's witness maps and L.C.R.C. #229.

L.C.R.C. #1791


SW cor. hse #1001 fnd. N 45° W 86.35'
 SE cor. hse. #2001 fnd. N 15° W 67.08'
 SW cor. hse. (no number) siding N 30° E 62.87'
 SE cor. hse. (no number) fnd. N 55° E 80.80'
 NW cor. hse. #2006 fnd. S 10° E 72.55'
 NE cor. hse. #1986 fnd. S 50° W 91.07'
 On C/L 4 Mile Road - E-W, C/L Vineyard South

P.A. 345 1990 KENT COUNTY
 PEER APPROVED 11/3/94
 CHAIRMAN *[Signature]*

The selected location is accepted by me and is generally accepted by professional surveyors as the best available evidence of the position of the original corner.

C. Description of monument for corner and accessories established to perpetuate locating the position of the corner:

F-1 Standard Kent County Monument
 SW cor. hse #1001 fnd. N 45° W 86.35'
 SE cor. hse. #2001 fnd. N 15° W 67.08'
 SW cor. hse. N 30° E 62.87'
 SE cor. hse. fnd. N 55° E 80.80'
 NW cor. hse. #2006 fnd. S 10° E 72.55'
 NE cor. hse. #1986 fnd. S 50° W 91.07'
 On C/L 4 Mile Road - E-W, C/L Vineyard South

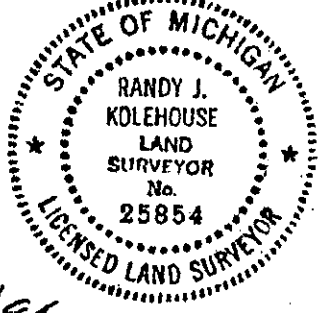

Signed by *Randy J. Kolehouse* Date 12/1/94
 Surveyor's Michigan License No. 25854