

SURVEY & REMONUMENTATION

APR 28 1995

COMMISSION

LAND CORNER RECORDATION CERTIFICATE
 Filing Requirement of Act 74, Mich. P.A. 1970
 KENT COUNTY REMONUMENTATION

STATE OF MICHIGAN
 COUNTY OF KENT
 RECEIVED FOR RECORD
 94 DEC 29 AM 11:12

For corners in Kent (County) Located in: _____ Corner Code # _____

1. Public Land Survey	T <u>7N</u>	R <u>11W</u>	<u>F-2</u>
	T _____	R _____	_____
	T _____	R _____	_____
	T _____	R _____	_____
2. Property Controlling in Section	S _____	T _____	R _____
	S _____	T _____	R _____
3. Miscellaneous Property in Sec.	S _____	T _____	R _____
	S _____	T _____	R _____

4. Lot No. _____, Recorded Plat _____
 5. Private Claims _____


W. J. Bond
 REG. OF DEEDS

7954

Register of Deeds Stamp & File Number

I, Randy Kolehouse, in a field survey on June 30, 19 94, do hereby certify that under requirements of P.A. 74 Michigan P.A. of 1970, the corner points mentioned in lines 1 and 2 above were in conformance with regulations and rules therefore as required in the current manual of survey instructions of the United States Department of the Interior, Bureau of Land Management or by a decree of a Court of Law and/or that the corner points mentioned in lines 3, 4 and 5 above were in conformance with the rules of the Michigan Board of Land Surveyors or by a Decree of a Court of Law; established, re-established, monumented, re-monumented, recovered, found as expressed below:

NOTE: Not more than 4 corners, all in the same town and range, may be recorded on this certificate.

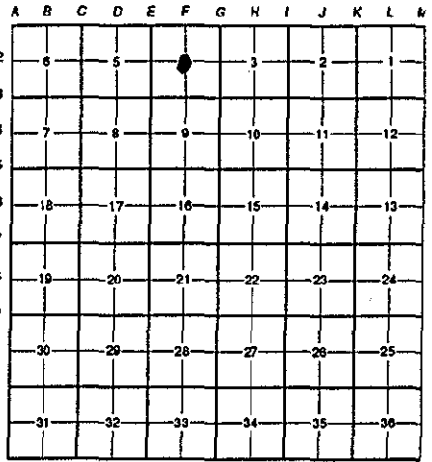

A. Description of original monument and accessories and/or subsequent restoration:

F-2 This corner was not originally set by the G.L.O.

1954	Survey Records	Williams & Works	Set Iron at 1/4 Lines
1954-1985	Survey Records	Williams & Works	Used Iron Set in 1954

No other information on corner.

B. Description of corner evidence found and/or method applied in restoring or reestablishing corner:

F-2 Found 3/4" iron in fence line as set by Williams & Works at the intersection of 1/4 lines 4.0' West and 3.9' North of the NW corner of Emerald Lake Gardens L. 38 P. 28 per their records. There are several other plats in this Section (Emerald Lake Terraces L. 38 P. 33; Haadsma Plat L. 38 P. 15; Brandau Farm Sub. L. 25 P. 13) all seeming to use a different Center Section which may be due to the West corner of Section 4 falling in Lambertson Lake. Williams & Works had set a temporary West 1/4 corner of Section 4 by prorating G.L.O. distance from the SW corner of Section 4 to the NW corner of Section 4 (2643.0' North of the SW corner of Section). Decided to hold the iron found at intersection of 1/4 lines as the Center of Section.


P.A. 345 1990 KENT COUNTY
 PEER APPROVED 12/1/94
 CHAIRMAN *[Signature]*

The selected location is accepted by me and is generally accepted by professional surveyors as the best available evidence of the position of the original corner.

C. Description of monument for corner and accessories established to perpetuate locating the position of the corner:

F-2 Replaced 3/4" iron with Standard 4" x 30" Kent County Monument.

- Nail & K.C. remon. tag in S side 10" Maple S 60° E 50.27'
- Nail & K.C. remon. tag in E side 8" Maple S 25° W 21.78'
- Nail & K.C. remon. tag in SW side 4" Aspen N 50° W 12.07'
- Nail & K.C. remon. tag in W side 4" Aspen N 15° W 25.00'
- Nail & K.C. remon. tag in N side 6"x8" Post S 85° E 20.55'

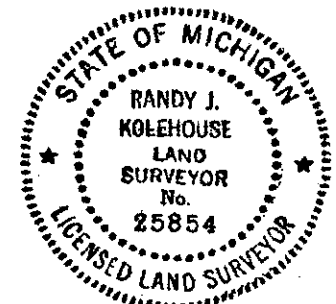

Signed by Randy J. Kolehouse Date 12/12/94
 Surveyor's Michigan License No. 25854