

**SURVEY & REMONUMENTATION**

APR 28 1995

**COMMISSION**

**LAND CORNER RECORDATION CERTIFICATE**  
 Filing Requirement of Act 74, Mich. P.A. 1970  
 KENT COUNTY REMONUMENTATION

For corners in

<u>Kent</u> (County)	Located in:	Corner Code #
1. Public Land Survey	T <u>7N</u> R <u>11W</u>	<u>F4</u>
	T _____ R _____	_____
	T _____ R _____	_____
	T _____ R _____	_____
2. Property Controlling in Section	S _____ T _____ R _____	_____
	S _____ T _____ R _____	_____
3. Miscellaneous Property In Sec.	S _____ T _____ R _____	_____
	S _____ T _____ R _____	_____


STATE OF MICHIGAN  
 COUNTY OF KENT  
 RECEIVED FOR RECORD  
 94 DEC 29 AM 11:12

*Lucy J. Bond*  
 REG. OF DEEDS

7955

Register of Deeds Stamp & File Number

4. Lot No. \_\_\_\_\_, Recorded Plat \_\_\_\_\_  
 5. Private Claims \_\_\_\_\_

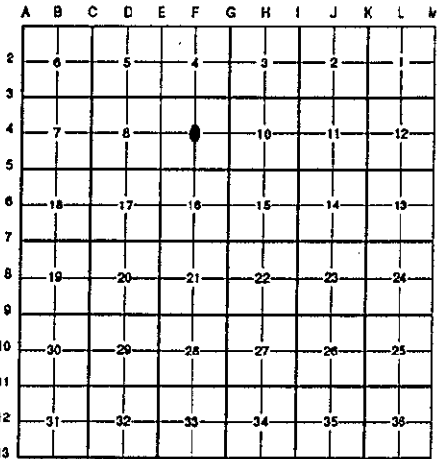

I, Randy Kolehouse, in a field survey on June 17 19 94, do hereby certify that under requirements of P.A. 74 Michigan P.A. of 1970, the corner points mentioned in lines 1 and 2 above were in conformance with regulations and rules therefore as required in the current manual of survey instructions of the United States Department of the interior, Bureau of Land Management or by a decree of a Court of Law and/or that the corner points mentioned in lines 3, 4 and 5 above were in conformance with the rules of the Michigan Board of Land Surveyors or by a Decree of a Court of Law; established, re-established, monumented, re-monumented, recovered, found as expressed below:

**NOTE: Not more than 4 corners, all in the same town and range, may be recorded on this certificate.**

A. Description of original monument and accessories and/or subsequent restoration:

F-4 This corner was not originally set by the G.L.O.

1904	Survey Records	Williams & Works	Set Gas Pipe
1946-1969	Survey Records	Williams & Works	Concrete Monument
1986	L.C.R.C. #4467	Williams & Works	"T" Iron
N/A	Survey Records	Exxel Engineering	"T" Iron

B. Description of corner evidence found and/or method applied in restoring or reestablishing corner:

F-4 This corner was originally set by Williams & Works in 1904 and used to present. Found "T" iron in Aberdeen Street running E-W per Exxel Engineering which "checks plats." Also checks Williams & Works survey records 1904-1969 and witnesses from L.C.R.C. #4467. "T" iron is 0.3' North and 8.9' West of intersection of 1/4 line. Accepted "T" iron as Center Section.


P.A. 345 1990 KENT COUNTY  
 PEER APPROVED 11/3/94  
 CHAIRMAN *Harry Kube*

The selected location is accepted by me and is generally accepted by professional surveyors as the best available evidence of the position of the original corner.

C. Description of monument for corner and accessories established to perpetuate locating the position of the corner:

F-4 Replaced "T" iron with Standard Kent County Monument.

- Nail in NE side 16" Oak S 60° E 53.40'
- Nail in NE side 14" Oak S 45° E 37.20'
- Nail in S side p. pole North 23.60'
- C/L steel yard light pole N 50° W 44.90'
- Fence corner post South 35.70'

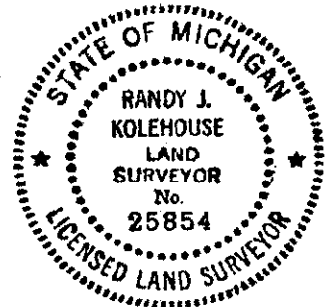

Signed by *Randy J. Kolehouse* Date 12/12/94  
 Surveyor's Michigan License No. 25854