

# SURVEY & REMONUMENTATION

STATE OF MICHIGAN  
COUNTY OF KENT  
RECEIVED FOR RECORD

APR 28 1995

## LAND CORNER RECORDATION CERTIFICATE Filing Requirement of Act 74, Mich. P.A. 1970 KENT COUNTY REMONUMENTATION

94 DEC -6 AM 9:02

For corners in

**COMMISSION**

Kent  
(County)

Located in:

Corner Code #


- |                                       |             |              |            |
|---------------------------------------|-------------|--------------|------------|
| 1. Public Land Survey                 | T <u>7N</u> | R <u>11W</u> | <u>F-7</u> |
|                                       | T _____     | R _____      | _____      |
|                                       | T _____     | R _____      | _____      |
|                                       | T _____     | R _____      | _____      |
| 2. Property Controlling in Section    | S _____     | T _____      | R _____    |
|                                       | S _____     | T _____      | R _____    |
| 3. Miscellaneous Property in Sec.     | S _____     | T _____      | R _____    |
|                                       | S _____     | T _____      | R _____    |
| 4. Lot No. _____, Recorded Plat _____ |             |              |            |
| 5. Private Claims _____               |             |              |            |

*Twigg*  
REG. OF DEEDS

**7805**

Register of Deeds Stamp & File Number

I, Randy Kolehouse, in a field survey on June 13 19 94, do hereby certify that under requirements of P.A. 74 Michigan P.A. of 1970, the corner points mentioned in lines 1 and 2 above were in conformance with regulations and rules therefore as required in the current manual of survey instructions of the United States Department of the Interior, Bureau of Land Management or by a decree of a Court of Law and/or that the corner points mentioned in lines 3, 4 and 5 above were in conformance with the rules of the Michigan Board of Land Surveyors or by a Decree of a Court of Law; established, re-established, monumented, re-monumented, recovered, found as expressed below:

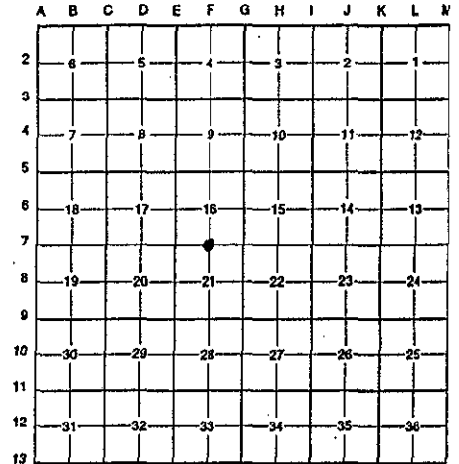

**NOTE: Not more than 4 corners, all in the same town and range, may be recorded on this certificate.**

**A. Description of original monument and accessories and/or subsequent restoration:**

F-7	1831	G.L.O. Notes	Mullett	Set Post
	1971	L.C.R.C. #100	Williams & Works	Iron in Mon. Box
	1979	Survey Records	Exxel Engineering	Iron in Mon. Box
	1984	L.C.R.C. #3921	William R. Byl	Fnd. Iron in Mon. Box/Set K.C. Mon.
	1988	L.C.R.C. #4580	Bueche	K.C. Monument

P.A. 345 1990 KENT COUNTY

PEER APPROVED 11/3/99  
CHAIRMAN *Handwritten Signature*

This corner was originally approved by the Kent County Remonumentation Peer Group and monumented by William R. Byl on 8/21/84 and was recorded per L.C.R.C. #3921.

**B. Description of corner evidence found and/or method applied in restoring or reestablishing corner:**

F-7 Found standard Kent County Monument in C/L of Leonard Street running E-W at C/L of Perkins running North per L.C.R.C.'s #3921 and #4580 as set by William R. Byl in place of a 1" iron in a monument box over a 1/2" iron he found which checked L.C.R.C. #100 and plats in area.

L.C.R.C. #3921

L.C.R.C. #4580


Nail & tag S side p. pole N 75° E 114.04'  
SE cor. brick church bldg. (3' abv. grade) N 20° W 144.47'  
SE cor. brick sign S 55° W 91.05'  
SW cor. bus stop shelter support pole (1.5' abv. grd.) S 30° E 63.52'  
Face of curb S 00° W 37.92'

Nail & tag S side p. pole N 75° E 114.04'  
SE cor. brick church bldg. (3' abv. grade) N 20° W 144.47'  
SE cor. brick sign S 55° W 91.05'  
SW cor. bus stop shelter support pole (1.5' abv. grd.) S 30° E 63.52'  
Face of curb S 00° W 37.92'

The selected location is accepted by me and is generally accepted by professional surveyors as the best available evidence of the position of the original corner.

**C. Description of monument for corner and accessories established to perpetuate locating the position of the corner:**

F-7 Standard Kent County Monument  
Nail & K.C. remon. tag S side p. pole N 75° E 114.04'  
SE cor. brick church bldg. (3' abv. grade) N 20° W 144.47'  
SE cor. brick sign S 55° W 91.05'  
SW cor. bus stop shelter support pole (1.5' abv. grd.) S 30° E 63.52'  
Face of curb S 00° W 37.92'

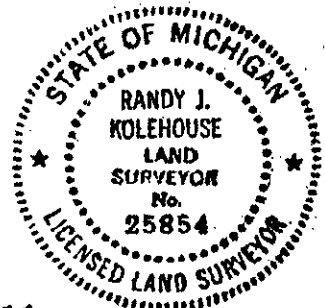

Signed by *Randy J. Kolehouse*  
Surveyor's Michigan License No. 25854

Date 12/1/04