

SURVEY & REMONUMENTATION

STATE OF MICHIGAN
COUNTY OF KENT
RECEIVED FOR RECORD

APR 28 1995

LAND CORNER RECORDATION CERTIFICATE
Filing Requirement of Act 74, Mich. P.A. 1970

94 DEC -6 AM 9:02

For corners in **COMMISSION**

KENT COUNTY REMONUMENTATION

Kent (County)	Located in:	Corner Code #
1. Public Land Survey	T <u>7N</u> R <u>11W</u>	<u>F-13</u>
	T _____ R _____	_____
	T _____ R _____	_____
	T _____ R _____	_____
2. Property Controlling in Section	S _____ T _____ R _____	_____
	S _____ T _____ R _____	_____
3. Miscellaneous Property in Sec.	S _____ T _____ R _____	_____
	S _____ T _____ R _____	_____

Bill Bond
REG. OF DEEDS

7807

Register of Deeds Stamp & File Number

4. Lot No. _____, Recorded Plat _____
5. Private Claims _____

	A	B	C	D	E	F	G	H	I	J	K	L	M
2	8	5	4	3	2	1							
3													
4	7	6	9	10	11	12							
5													
6	18	17	16	15	14	13							
7													
8	19	20	21	22	23	24							
9													
10	30	29	28	27	26	25							
11													
12	31	32	33	34	35	36							
13													

I, Randy Kolehouse, in a field survey on July 13 19 94, do hereby certify that under requirements of P.A. 74 Michigan P.A. of 1970, the corner points mentioned in lines 1 and 2 above were in conformance with regulations and rules therefore as required in the current manual of survey instructions of the United States Department of the Interior, Bureau of Land Management or by a decree of a Court of Law and/or that the corner points mentioned in lines 3, 4 and 5 above were in conformance with the rules of the Michigan Board of Land Surveyors or by a Decree of a Court of Law; established, re-established, monumented, re-monumented, recovered, found as expressed below:

NOTE: Not more than 4 corners, all in the same town and range, may be recorded on this certificate.

A. Description of original monument and accessories and/or subsequent restoration:

Set Post	G.L.O. Notes	L. Lyon	Set K.C. Mon.
-13 1831	1985	1988	
	L.C.R.C. #4237	L. Lyon	Set K.C. Mon.
	L.C.R.C. #4582	William R. Byl	K.C. Monument
		Bueche	

P.A. 345 1990 KENT COUNTY
PEER APPROVED 11/13/94
CHAIRMAN *Henry Thudue*

This corner was originally approved by the Kent County Remonumentation Peer Group and monumented by William R. Byl on 5/14/85 and was recorded per L.C.R.C. #4237.

B. Description of corner evidence found and/or method applied in restoring or reestablishing corner:

-13 Found standard Kent County Monument in Hall Street running E-W per L.C.R.C.'s #4237 and #4582 as set by William R. Byl using the following Plats (Raymond Park 1888) (San La Rae 1913) and (Alberts Realtors Hall Street Sub. 1941).

L.C.R.C. #4237

L.C.R.C. #4582


SW cor. brick veneer hse. #2005 N 40° E 76.88'
NE cor. brick veneer hse. #1978 1' above grade S 40° W 78.67'
NE cor. stone veneer hse. #2000 S 25° E 74.33'
K.C. Monument @ N 1/4 cor. Sec. 4 T6N R11W N 90° W 38.91'

SW cor. brick veneer hse. #2005 N 40° E 76.88'
NE cor. brick veneer hse. #1978 1' above grade S 40° W 78.67'
NE cor. stone veneer hse. #2000 S 25° E 74.33'
K.C. Monument @ N 1/4 cor. Sec. 4 T6N R11W N 90° W 38.91'
Cor. is 89' W of C/L Wilshire St. to S

The selected location is accepted by me and is generally accepted by professional surveyors as the best available evidence of the position of the original corner.

C. Description of monument for corner and accessories established to perpetuate locating the position of the corner:

-13 Standard Kent County Monument
SW cor. brick veneer hse. #2005 N 40° E 76.88'
NE cor. brick veneer hse. #1978 1' above grade S 40° W 78.67'
NE cor. stone veneer hse. #2000 S 25° E 74.33'
K.C. Monument @ N 1/4 cor. Sec. 4 T6N R11W N 90° W 38.91'
Cor. is 89' W of C/L Wilshire St. to S

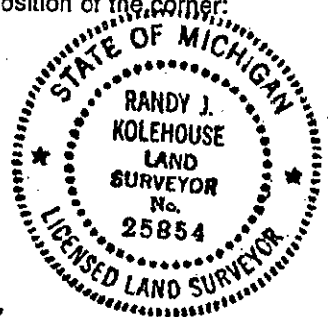

Surveyed by Randy J. Kolehouse
Surveyor's Michigan License No. 25854

Date 12/1/94