

**SURVEY & REMONUMENTATION**

APR 28 1995

**COMMISSION**

**LAND CORNER RECORDATION CERTIFICATE**  
 Filing Requirement of Act 74, Mich. P.A. 1970  
 KENT COUNTY REMONUMENTATION

STATE OF MICHIGAN  
 COUNTY OF KENT  
 RECEIVED FOR RECORD

94 DEC -6 AM 9:02

For corners in


Kent (County)	Located in:	Corner Code #
1. Public Land Survey	T <u>7N</u> R <u>11W</u>	<u>G-3</u>
	T _____ R _____	_____
	T _____ R _____	_____
	T _____ R _____	_____
2. Property Controlling in Section	S _____ T _____ R _____	_____
	S _____ T _____ R _____	_____
3. Miscellaneous Property in Sec.	S _____ T _____ R _____	_____
	S _____ T _____ R _____	_____

*W. J. Bond*  
 REG. OF DEEDS

7810

Register of Deeds Stamp & File Number

- 4. Lot No. \_\_\_\_\_, Recorded Plat \_\_\_\_\_
- 5. Private Claims \_\_\_\_\_

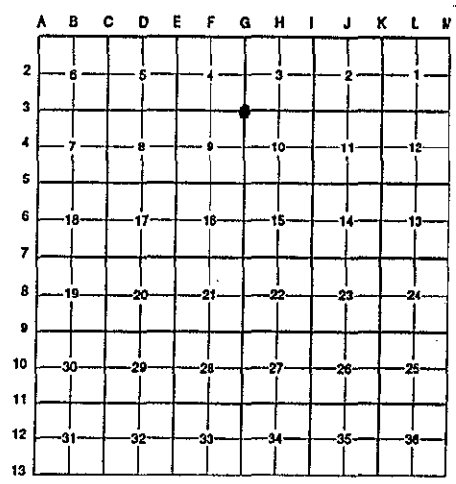

I, Randy Kolehouse, in a field survey on July 16 19 94, do hereby certify that under requirements of P.A. 74 Michigan P.A. of 1970, the corner points mentioned in lines 1 and 2 above were in conformance with regulations and rules therefore as required in the current manual of survey instructions of the United States Department of the Interior, Bureau of Land Management or by a decree of a Court of Law and/or that the corner points mentioned in lines 3, 4 and 5 above were in conformance with the rules of the Michigan Board of Land Surveyors or by a Decree of a Court of Law; established, re-established, monumented, re-monumented, recovered, found as expressed below:

NOTE: Not more than 4 corners, all in the same town and range, may be recorded on this certificate.

A. Description of original monument and accessories and/or subsequent restoration:

G-3	1831	G.L.O. Notes	Mullett	Set Post	P.A. 345 1990 KENT COUNTY
	1972	L.C.R.C. #445	Medema Van Kooten	"+" in Bridge	PEER APPROVED <u>11/31/94</u>
	1973	L.C.R.C. #596	Exxel Engineering	"+" in Bridge	CHAIRMAN <u>Henry Huber</u>
	1973	Survey Records	Williams & Works	"+" in Bridge	
	1985	L.C.R.C. #4286	William R. Byl	Fnd. P.K. in Bridge/Set K.C. Mon.	
	1988	L.C.R.C. #4584	Bueche	P.K. and K.C. Monument	

This corner was originally approved by the Kent County Remonumentation Peer Group and monumented by William R. Byl on 1/29/85 and was recorded per L.C.R.C. #4286.

B. Description of corner evidence found and/or method applied in restoring or reestablishing corner:

G-3 Found standard Kent County Monument under P.K. in bridge deck (3 Mile Road) running E-W per L.C.R.C.'s #4286 and #4584. Monument was set by William R. Byl under P.K. in bridge deck which checked Shadowlane Plat and Medema Van Kooten survey records.

L.C.R.C. #4286

L.C.R.C. #4584

- "V" cut E'ly corner of S'ly bridge pillar S 10° W 15.35'
- "V" cut E'ly corner of N'ly bridge pillar N 75° W 43.68'
- "V" cut E'ly face of concrete wall S 30° W 15.35'
- "+" in top N'ly culvert headwall N 60° W 51.31'
- "+" in top S'ly culvert headwall S 30° E 40.25'

- "V" cut E'ly corner of S'ly bridge pillar S 10° W 15.35'
- "V" cut E'ly corner of N'ly bridge pillar N 75° W 43.68'
- "V" cut E'ly face of concrete wall S 30° W 15.35'
- "+" in top N'ly culvert headwall N 60° W 51.31'
- "+" in top S'ly culvert headwall S 30° E 40.25'

Witnesses to PK nail in bridge deck:  
 NW cor. c. basin casting S 80° E 85.59' face of curb/railing N 0° E 14.25'  
 SW cor. c. basin casting N 75° E 54.49' face of curb/railing S 0° W 14.28'

The selected location is accepted by me and is generally accepted by professional surveyors as the best available evidence of the position of the original corner.

C. Description of monument for corner and accessories established to perpetuate locating the position of the corner:

- G-3 Standard Kent County Monument
- "V" cut E'ly corner of S'ly bridge pillar S 10° W 15.35'
- "V" cut E'ly corner of N'ly bridge pillar N 75° W 43.68'
- "V" cut E'ly face of concrete wall S 30° W 15.35'
- "+" in top N'ly culvert headwall N 60° W 51.31'
- "+" in top S'ly culvert headwall S 30° E 40.25'

Witnesses to PK nail in bridge deck:  
 NW cor. c. basin casting S 80° E 85.59'  
 SW cor. c. basin casting N 75° E 54.49'  
 Face of curb/railing N 0° E 14.25'  
 Face of curb/railing S 0° W 14.28'



Signed by Randy J. Kolehouse  
 Surveyor's Michigan License No. 25854

Date 12/1/94