

# SURVEY & REMONUMENTATION

APR 28 1995

STATE OF MICHIGAN  
COUNTY OF KENT  
RECEIVED FOR RECORD

## LAND CORNER RECORDATION CERTIFICATE

Filing Requirement of Act 74, Mich. P.A. 1970

94 DEC -6 AM 9:02

## COMMISSION

KENT COUNTY REMONUMENTATION

For corners in


*W. J. Jones*  
REG. OF DEEDS

For corners in	Located in:	Corner Code #
<u>Kent</u> (County)		
1. Public Land Survey	T <u>7N</u> R <u>11W</u>	<u>G-5</u>
	T _____ R _____	_____
	T _____ R _____	_____
	T _____ R _____	_____
2. Property Controlling in Section	S _____ T _____ R _____	_____
	S _____ T _____ R _____	_____
3. Miscellaneous Property in Sec.	S _____ T _____ R _____	_____
	S _____ T _____ R _____	_____

7812

Register of Deeds Stamp & File Number

4. Lot No. \_\_\_\_\_, Recorded Plat \_\_\_\_\_  
5. Private Claims \_\_\_\_\_

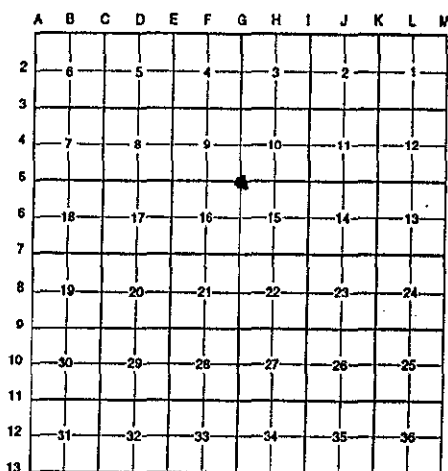

I, Randy Kolehouse, in a field survey on July 16 19 94, do hereby certify that under requirements of P.A. 74 Michigan P.A. of 1970, the corner points mentioned in lines 1 and 2 above were in conformance with regulations and rules therefore as required in the current manual of survey instructions of the United States Department of the Interior, Bureau of Land Management or by a decree of a Court of Law and/or that the corner points mentioned in lines 3, 4 and 5 above were in conformance with the rules of the Michigan Board of Land Surveyors or by a Decree of a Court of Law; established, re-established, monumented, re-monumented, recovered, found as expressed below:

NOTE: Not more than 4 corners, all in the same town and range, may be recorded on this certificate.

A. Description of original monument and accessories and/or subsequent restoration:

G-5	1831	G.L.O. Notes	Mullett	Set Post
	1985	L.C.R.C. #4287	William R. Byl	Set K.C. Monument
	1988	L.C.R.C. #4586	Bueche	K.C. Monument

P.A. 345 1990 KENT COUNTY  
PEER APPROVED 11/17/94  
CHAIRMAN *Harry Hubers*

This corner was originally approved by the Kent County Remonumentation Peer Group and monumented by William R. Byl on 4/23/85 and was recorded per L.C.R.C. #4287.

B. Description of corner evidence found and/or method applied in restoring or reestablishing corner:

G-5 Found standard Kent County Monument at approximately 1' South of C/L of Knapp Street running E-W per L.C.R.C.'s #4287 and #4586 as set by William R. Byl using 1910-1969 survey records from Williams & Works. (Note - this point is 1.67' West of monument box recorded in L.C.R.C.'s #1276 and #4158.

L.C.R.C. #4287

L.C.R.C. #4586

Nail & tag E side 6" Hickory N 25° E 55.06'  
Nail & tag E side 6" Hickory N 45° E 71.07'  
Nail & tag W side 24" Hickory N 45° W 111.11'

Nail & tag E side 8" Elm N 25° E 55.06'  
Nail & tag E side 8" Elm N 45° E 71.07'  
Nail & tag W side 26" Hickory N 45° W 111.11'  
Capped re-rod S 0° W 32.96'  
Capped re-rod N 0° W 33.05'

The selected location is accepted by me and is generally accepted by professional surveyors as the best available evidence of the position of the original corner.

C. Description of monument for corner and accessories established to perpetuate locating the position of the corner:

G-5 Standard Kent County Monument  
Nail & K.C. remon. tag E side 8" Elm N 25° E 55.06'  
Nail & K.C. remon. tag E side 8" Elm N 45° E 71.07'  
Nail & K.C. remon. tag W side 26" Hickory N 45° W 111.11'  
Capped re-rod S 0° W 32.96'  
Capped re-rod N 0° W 33.05'



Signed by *Randy J. Kolehouse*  
Surveyor's Michigan License No. 25854

Date 12/1/94