

**SURVEY & REMONUMENTATION**

APR 28 1995

STATE OF MICHIGAN  
COUNTY OF KENT  
RECEIVED FOR RECORD

**COMMISSION LAND CORNER RECORDATION CERTIFICATE**

Filing Requirement of Act 74, Mich. P.A. 1970

DEC -6 AM 9:02

KENT COUNTY REMONUMENTATION

For corners in


Kent (County)	Located in:	Corner Code #
1. Public Land Survey	T <u>7N</u> R <u>11W</u>	<u>G-8</u>
	T _____ R _____	_____
	T _____ R _____	_____
	T _____ R _____	_____
2. Property Controlling in Section	S _____ T _____ R _____	_____
	S _____ T _____ R _____	_____
3. Miscellaneous Property in Sec.	S _____ T _____ R _____	_____
	S _____ T _____ R _____	_____

*Randy Kolehouse*  
REG. OF DEEDS

7815

Register of Deeds Stamp & File Number

4. Lot No. \_\_\_\_\_, Recorded Plat \_\_\_\_\_  
5. Private Claims \_\_\_\_\_

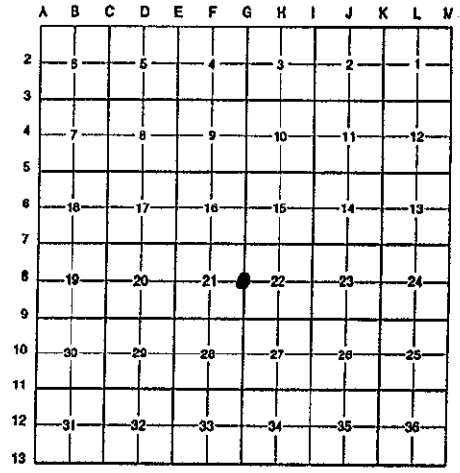

I, Randy Kolehouse, in a field survey on May 31 19 94, do hereby certify that under requirements of P.A. 74 Michigan P.A. of 1970, the corner points mentioned in lines 1 and 2 above were in conformance with regulations and rules therefore as required in the current manual of survey instructions of the United States Department of the Interior, Bureau of Land Management or by a decree of a Court of Law and/or that the corner points mentioned in lines 3, 4 and 5 above were in conformance with the rules of the Michigan Board of Land Surveyors or by a Decree of a Court of Law; established, re-established, monumented, re-monumented, recovered, found as expressed below:

NOTE: Not more than 4 corners, all in the same town and range, may be recorded on this certificate.

A. Description of original monument and accessories and/or subsequent restoration:

G-8	1831	G.L.O. Notes	Mullett	Set Post
	1951	Wit. Map	K.C. Surveyor	3/4" Iron
	1972	L.C.R.C. #99	Williams & Works	3/4" Solid Iron In Mon. Box
	1982	L.C.R.C. #2767	Williams & Works	Fnd. Iron in Mon. Box/Set K.C. Mon.
	1988	L.C.R.C. #4576	Bueche	K.C. Mon.

This corner was originally approved by the Kent County Remonumentation Peer Group and monumented by Williams & Works on 3/3/82 and was recorded per L.C.R.C. #2767 and also recorded on 3/3/88 per L.C.R.C. 4576.

B. Description of corner evidence found and/or method applied in restoring or reestablishing corner:

G-8 Found standard Kent County Monument in the C/L of Maryland Avenue running N-S per L.C.R.C.'s #2767 and #4576 as set by Williams & Works in place of a 3/4" iron in a monument box they found which checked L.C.R.C. #99.

L.C.R.C. #2767

L.C.R.C. #4576

NE comer concrete bridge walk S 22° W 47.30'  
NW comer concrete bridge walk S 15° E 47.30'  
Top C/L fence post E 59.81'


NE comer concrete bridge walk S 22° W 47.30'  
NW comer concrete bridge walk S 15° E 47.30'  
Top C/L fence post E 59.81'  
Nail & K.C. remon. tag in N side p. pole S 85° W 35.52'  
Nail & K.C. remon. tag in N side 12" Maple N 60° W 59.97'  
Mon. on C/L N-S bit. road (Maryland Ave.)

The selected location is accepted by me and is generally accepted by professional surveyors as the best available evidence of the position of the original corner.

C. Description of monument for corner and accessories established to perpetuate locating the position of the corner:

G-8 Standard Kent County Monument  
NE comer concrete bridge walk S 22° W 47.30'  
NW comer concrete bridge walk S 15° E 47.30'  
Top C/L fence post E 59.81'  
Nail & K.C. remon. tag in N side p. pole S 85° W 35.52'  
Nail & K.C. remon. tag in N side 12" Maple N 60° W 59.97'  
Mon. on C/L N-S bit. road (Maryland Ave.)

P.A. 345 1990 KENT COUNTY,  
PEER APPROVED 12/12/94  
CHAIRMAN *Randy Kolehouse*

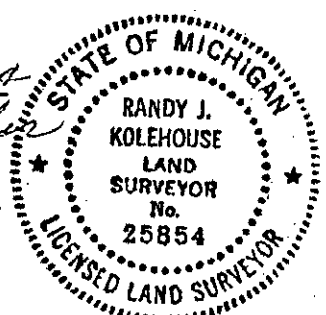

Signed by *Randy J. Kolehouse*  
Surveyor's Michigan License No. 25854

Date 12/1/94