

SURVEY & REMONUMENTATION

APR 28 1995

LAND CORNER RECORDATION CERTIFICATE
 Filing Requirement of Act 74, Mich. P.A. 1970
KENT COUNTY REMONUMENTATION

COMMISSION

STATE OF MICHIGAN
 COUNTY OF KENT
 RECEIVED FOR RECORD
 94 DEC -6 AM 9:02

Lee J. Bond
 REG. OF DEEDS

7816
 Register of Deeds Stamp & File Number

For comers in Kent (County) Located in: Corner Code #


1. Public Land Survey T 7N R 11W G-9
 T _____ R _____
 T _____ R _____
 T _____ R _____

2. Property Controlling in Section S _____ T _____ R _____
 S _____ T _____ R _____

3. Miscellaneous Property in Sec. S _____ T _____ R _____
 S _____ T _____ R _____

4. Lot No. _____, Recorded Plat _____

5. Private Claims _____

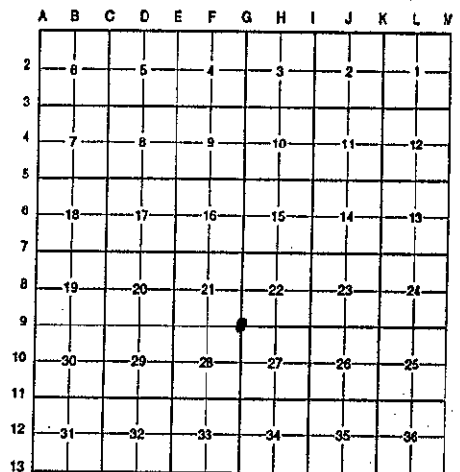

I, Randy Kolehouse, in a field survey on May 31 19 94, do hereby certify that under requirements of P.A. 74 Michigan P.A. of 1970, the corner points mentioned in lines 1 and 2 above were in conformance with regulations and rules therefore as required in the current manual of survey instructions of the United States Department of the Interior, Bureau of Land Management or by a decree of a Court of Law and/or that the corner points mentioned in lines 3, 4 and 5 above were in conformance with the rules of the Michigan Board of Land Surveyors or by a Decree of a Court of Law; established, re-established, monumented, re-monumented, recovered, found as expressed below:

NOTE: Not more than 4 corners, all in the same town and range, may be recorded on this certificate.

A. Description of original monument and accessories and/or subsequent restoration:

1831	G.L.O. Notes	Mullett	Set Post
1951	Wit. Map	K.C. Surveyor	Iron in Mon. Box
1974	L.C.R.C. #745	Exxel Engineering	P.K. Nail in Mon. Box
1982	L.C.R.C. #2768	Williams & Works	Fnd. P.K. in Iron in Mon. Box/Set K.C. Mon.
1988	L.C.R.C. #4577	Bueche	K.C. Mon.

This corner was originally approved by the Kent County Remonumentation Peer Group and monumented by Williams & Works on 3/3/82 and was recorded per L.C.R.C. #2768.


B. Description of corner evidence found and/or method applied in restoring or reestablishing corner:
 Found standard Kent County Monument at approximate C/L intersection of Michigan Street running E-W and Maryland Avenue running North and South per L.C.R.C.'s #2768 and #4577 as set by Williams & Works in place of a P.K. nail in the top of a 3/4" iron in a monument box they found which checked 1951 K.C. Surveyor's witness map and L.C.R.C. #745.

L.C.R.C. #2768	L.C.R.C. #4577
Nail & K.C. remon. tag in NE side P.T. & TV pole N 50° W 49.08' Top C/L hydrant S 25° E 68.27' C/L joint of Michigan St. is S 1.0'± Corner is on C/L ± of Maryland Avenue	Nail & K.C. remon. tag in NE side P.T. & TV pole N 50° W 49.08' Top C/L hydrant S 25° E 68.27' C/L joint of Michigan St. is S 1.0' M/L Corner is on C/L M/L of Maryland Avenue NE cor. garage siding S 60° W 104.18'

The selected location is accepted by me and is generally accepted by professional surveyors as the best available evidence of the position of the original corner.

C. Description of monument for corner and accessories established to perpetuate locating the position of the corner:
 Standard Kent County Monument
 Nail & K.C. remon. tag in NE side p. t & TV pole N 50° W 49.08'
 Top C/L hydrant S 25° E 68.27'
 NE cor. garage siding S 60° W 104.18'

P.A. 345 1990 KENT COUNTY
 PEER APPROVED 10/12/94
 CHAIRMAN *[Signature]*

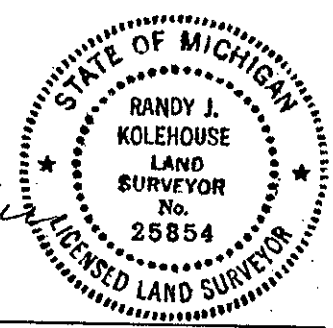

Surveyed by Randy J. Kolehouse
 Surveyor's Michigan License No. 25854

Date 12/1/94