SURVEY & REMONUMENTATION

APR 28 1995

COMMISSION

STATE OF MICHIGAN
COUNTY OF KENT
RECEIVED FOR RECORD

94 DEC -6 AM 9:02

REG. OF DEEDS

LAND CORNER RECORDATION CERTIFICATE

Filing Requirement of Act 74, Mich. P.A. 1970

KENT COUNTY REMONUMENTATION

For corners in Kent (County) Located in: Corner Code #

1. Public Land Survey T 7N R 11W G-13
   T ___ R ___
   T ___ R ___
   T ___ R ___
2. Property Controlling S ___ T ___ R ___
   in Section S ___ T ___ R ___
3. Miscellaneous S ___ T ___ R ___
   Property in Sec. S ___ T ___ R ___

7818

Register of Deeds Stamp & File Number

4. Lot No. ___, Recorded Plat ___
5. Private Claims ___

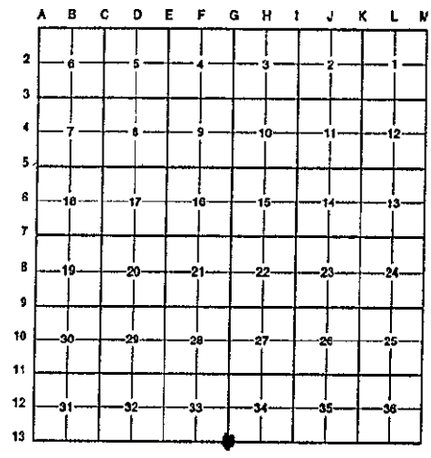

I, Randy Kolehouse, in a field survey on July 15 19 94, do hereby certify that under requirements of P.A. 74 Michigan P.A. of 1970, the corner points mentioned in lines 1 and 2 above were in conformance with regulations and rules therefore as required in the current manual of survey instructions of the United States Department of the interior, Bureau of Land Management or by a decree of a Court of Law and/or that the corner points mentioned in lines 3, 4 and 5 above were in conformance with the rules of the Michigan Board of Land Surveyors or by a Decree of a Court of Law; established, re-established, monumented, re-monumented, recovered, found as expressed below:

NOTE: Not more than 4 corners, all in the same town and range, may be recorded on this certificate.

A. Description of original monument and accessories and/or subsequent restoration:

G-13	1831	G.L.O. Notes	L. Lyon	Set Post
	1907-1947	Survey Records	Williams & Works	Stake/Iron Bolt
	1924	Survey Records	City of East Grand Rapids	Iron
	1985	L.C.R.C. #4238	William R. Byl	Set K.C. Mon.
	1988	L.C.R.C. #4667	Bueche	K.C. Mon.

P.A. 345 1990 KENT COUNTY PEER APPROVED 11/3/94 CHAIRMAN

This corner was originally approved by the Kent County Remonumentation Peer Group and monumented by William R. Byl on 5/3/85 and was recorded per L.C.R.C. #4238.

B. Description of corner evidence found and/or method applied in restoring or reestablishing corner:

G-13 Found standard Kent County Monument at the intersection of Hall Street running E-W and Brenton Avenue running N-S per L.C.R.C.'s #4238 and #4667 as set by William R. Byl using survey records from Williams & Works. This point also checked Albert Realtors Plat.

L.C.R.C. #4238

Face of gas vault vent pipe 3' above grade N 90° E 105.08'

L.C.R.C. #4667

Face of gas vault vent pipe 3' above grade N 90° E 105.08'
Nail & tag E side traffic signal pole S 10° W 49.57'
K.C. Mon. NE cor. Sec. 4 6-11 N 90° W 52.24'
Inter. back walks N 45° E 49.43'

The selected location is accepted by me and is generally accepted by professional surveyors as the best available evidence of the position of the original corner.

C. Description of monument for corner and accessories established to perpetuate locating the position of the corner:

G-13 Standard Kent County Monument
Face of gas vault vent pipe 3' above grade N 90° E 105.08'
Nail & K.C. remon. tag E side traffic signal pole S 10° W 49.57'
K.C. Mon. NE cor. Sec. 4 T6N R11W N 90° W 52.24'
Inter. back walks N 45° E 49.43'
Nail & K.C. remon. tag E Face p. pole N 05° W 57.22'

STATE OF MICHIGAN
RANDY J. KOLEHOUSE
LAND SURVEYOR
No. 25854
LICENSED LAND SURVEYOR

Signed by Randy J. Kolehouse Date 12/1/94

Surveyor's Michigan License No. 25854

FORM APPROVED BY MICHIGAN STATE BOARD OF LAND SURVEYORS, JAN. 28, 1971
REVISED MAY 14, 1975
REVISED JAN., 1983