

**SURVEY & REMONUMENTATION**

\$7.00  
\$2.00

APR 28 1995

**LAND CORNER RECORDATION CERTIFICATE**

STATE OF MICHIGAN  
COUNTY OF KENT  
RECEIVED FOR RECORD

94 DEC 16 AM 9:23

**COMMISSION**

Filing Requirement of Act 74, Mich. P.A. 1970  
Kent County Remonumentation

For corners in

Kent (County)	Located In:	Corner Code #
1. Public Land Survey	T <u>7N</u> R <u>11W</u>	H-2 (Center, Sec 3)
	T _____ R _____	_____
	T _____ R _____	_____
	T _____ R _____	_____
2. Property Controlling in Section	S _____ T _____ R _____	_____
	S _____ T _____ R _____	_____
3. Miscellaneous Property in Sec.	S _____ T _____ R _____	_____
	S _____ T _____ R _____	_____


*Tim J. Bond*  
REG. OF DEEDS

7849

Register of Deeds Stamp & File Number

4. Lot No. \_\_\_\_\_, Recorded Plat \_\_\_\_\_  
5. Private Claims \_\_\_\_\_

I, James C. Glaza, in a field survey on November 29, 19 94, do hereby certify that under requirements of P.A. 74, Michigan P.A. of 1970, the corner points mentioned in lines 1 and 2 above were in conformance with regulations and rules therefore as required in the current manual of survey instructions of the United States Department of the Interior, Bureau of Land Management or by a decree of a Court of Law and/or that the corner points mentioned in lines 3, 4 and 5 above were in conformance with the rules of the Michigan Board of Land Surveyors or by a Decree of a Court of Law; established, re-established, monumented, re-monumented, recovered, found as expressed below:

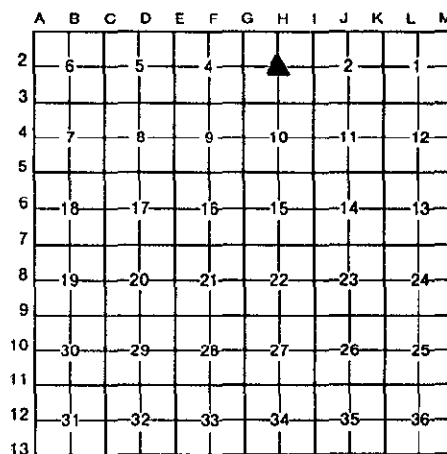

**NOTE: Not more than 4 corners, all in the same town and range, may be recorded on this certificate.**

**A. Description of original monument and accessories and/or subsequent restoration:**

H-2	This corner not originally set by G.L.O.		
1919	survey records	Williams & Works	gas pipe
1945	survey records	Williams & Works	set iron @ intersection of
1951-1960	survey records	Williams & Works	iron $\frac{1}{4}$ lines
1975	survey records	Exxel	iron
1984	LCRC #3736	Meyer	concrete plat mon.
1989		Exxel	concrete mon.

**B. Description of corner evidence found and/or method applied in restoring or reestablishing corner:**

H-2 Found concrete monument - NE corner of Whispering Pines No. 2 (plat) as recorded in Liber 66 of Plats, Page 40. Remaining witnesses check with those recorded in 1984 (LCRC #3736) by Allan Meyer. This monument is 1.1' South and 0.4' West of the intersection of the  $\frac{1}{4}$  lines. The Kent County Remonumentation Peer Group approved the monument as the center of section.

LCRC #3736

Nail in East side fence post	South	1.55'
Nail in SW side 12" Elm	N50°W	21.53'
Nail in E'ly side 14" Oak	N35°E	51.18'
Nail in South side 12" W. Cherry	East	33.86'

**C. Description of monument for corner and accessories established to perpetuate locating the position of the corner:**

H-2 Placed plastic Kent County remon. cap on concrete monument.

Set K.C. remon tag & nail in E'ly side 20" Oak	N35°E	51.15'
Set K.C. remon tag & nail in South side 14" W. Cherry	N85°E	33.91'
K.C. remon tag & nail in East side 8" Twin Apple	S15°E	7.02'
K.C. remon tag & nail in South side 12" W. Cherry	N85°W	28.64'



P.A. 345 1990 KENT COUNTY  
PEER APPROVED 9/22/94  
CHAIRMAN Harry Huber

Signed by James C. Glaza  
Glaza & Associates, Inc. 40166  
Surveyor's Michigan License No. \_\_\_\_\_

December 12, 1994