

# SURVEY & REMONUMENTATION

APR 28 1995

## COMMISSION

### LAND CORNER RECORDATION CERTIFICATE Filing Requirement of Act 74, Mich. P.A. 1970 KENT COUNTY REMONUMENTATION

STATE OF MICHIGAN  
COUNTY OF KENT  
RECEIVED FOR RECORD

94 DEC -6 AM 9:02

*W. J. Colehouse*  
REG. OF DEEDS


7819  
Register of Deeds Stamp & File Number

For corners in \_\_\_\_\_  
Kent (County) Located in: Corner Code #

|                                    |             |              |                 |
|------------------------------------|-------------|--------------|-----------------|
| 1. Public Land Survey              | T <u>7N</u> | R <u>11W</u> | _____ H-9 _____ |
|                                    | T _____     | R _____      | _____           |
|                                    | T _____     | R _____      | _____           |
|                                    | T _____     | R _____      | _____           |
|                                    | T _____     | R _____      | _____           |
| 2. Property Controlling in Section | S _____     | T _____      | R _____         |
|                                    | S _____     | T _____      | R _____         |
| 3. Miscellaneous Property in Sec.  | S _____     | T _____      | R _____         |
|                                    | S _____     | T _____      | R _____         |

4. Lot No. \_\_\_\_\_, Recorded Plat \_\_\_\_\_

5. Private Claims \_\_\_\_\_

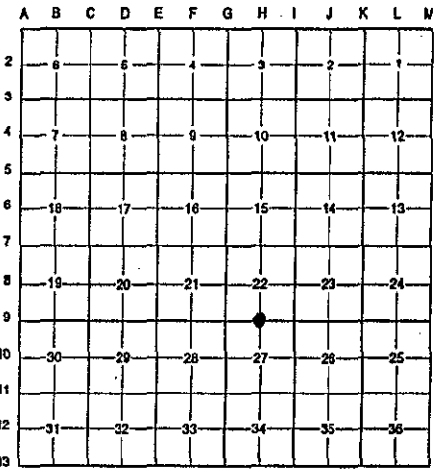

I, Randy Kolehouse, in a field survey on June 10 19 94, do hereby certify that under requirements of P.A. 74 Michigan P.A. of 1970, the corner points mentioned in lines 1 and 2 above were in conformance with regulations and rules therefore as required in the current manual of survey instructions of the United States Department of the Interior, Bureau of Land Management or by a decree of a Court of Law and/or that the corner points mentioned in lines 3, 4 and 5 above were in conformance with the rules of the Michigan Board of Land Surveyors or by a Decree of a Court of Law; established, re-established, monumented, re-monumented, recovered, found as expressed below:

**NOTE:** Not more than 4 corners, all in the same town and range, may be recorded on this certificate.

A. Description of original monument and accessories and/or subsequent restoration:

|      |                     |                   |                                     |
|------|---------------------|-------------------|-------------------------------------|
| -1-9 | 1831 G.L.O. Notes   | Mullet            | Set Post                            |
|      | 1960 Wit. Map       | K.C. Surveyor     | Gas Pipe                            |
|      | 1972 L.C.R.C. #307  | MDOT              | Pipe in Mon. Box                    |
|      | 1982 L.C.R.C. #2771 | Williams & Works  | Fnd. Iron in Mon. Box/Set K.C. Mon. |
|      | 1983 L.C.R.C. #3665 | Exxel Engineering | Reset K.C. Mon.                     |
|      | 1991 L.C.R.C. #6382 | Marschall         | K.C. Monument                       |

This corner was originally approved by the Kent County Remonumentation Peer Group and monumented by Williams & Works on 3/8/83 and was recorded per L.C.R.C. #2771.


B. Description of corner evidence found and/or method applied in restoring or reestablishing corner:

|   |   |
|---|---|
| -1-9 Found standard Kent County Monument at the intersection of Michigan Street running E-W and Lefingwell Avenue running North per L.C.R.C.'s #3665 and #6382 as reset by Exxel Engineering after street reconstruction at the location of a K.C. monument set by Williams & Works in place of a 3/4" iron in a monument box they found which checked K.C. Surveyor's witness map and L.C.R.C. #307. |   |
| L.C.R.C. #3665  | L.C.R.C. #6382                                |
| Nail in SW side 30" Oak N 31° W 88.83'  | Nail & tag SW side 36" Oak N 31° W 88.77'     |
| 'Nail in S side 14" Hickory N 61° W 120.11'   | Nail & tag S side utl. pole N 63° W 57.33'    |
| Nail in N side 8" Spruce S 54° E 128.32'  | Top C/L nut hyd. S 15° W 31.24'               |
| C/L hydrant (top) S 13° W 31.27'  | Nail & tag N side 10" Spruce S 51° E 128.26'  |
|   | Nail & tag SE side p. pole N 80° E 144.06'    |
|   | Nail & tag S side 16" Hickory N 67° W 120.14' |

The selected location is accepted by me and is generally accepted by professional surveyors as the best available evidence of the position of the original corner.

C. Description of monument for corner and accessories established to perpetuate locating the position of the corner:

|   |                                 |
|---|---------------------------------|
| -9 Standard Kent County Monument                          |                                 |
| Nail & K.C. remon. tag SW side 36" Oak N 31° W 88.77'     | P.A. 345 1990 KENT COUNTY       |
| Nail & K.C. remon. tag S side utl. pole N 63° W 57.33'    | PEER APPROVED <u>11/3/94</u>    |
| Top C/L nut hyd. S 15° W 31.24'                           | CHAIRMAN <u>Randy Kolehouse</u> |
| Nail & K.C. remon. tag N side 10" Spruce S 51° E 128.26'  |                                 |
| Nail & K.C. remon. tag SE side p. pole N 80° E 144.06'    |                                 |
| Nail & K.C. remon. tag S side 16" Hickory N 67° W 120.14' |                                 |

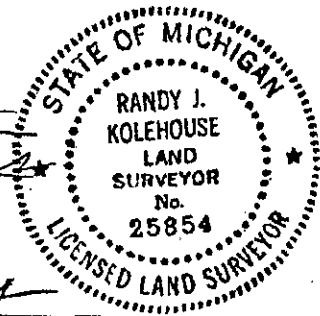

Signed by Randy J. Kolehouse  
Surveyor's Michigan License No. 25854

Date 12/1/94