

\$7.00
\$2.00

SURVEY & REMONUMENTATION

APR 28 1995

LAND CORNER RECORDATION CERTIFICATE

Filing Requirement of Act 74, Mich. P.A. 1970

Kent County Remonumentation

STATE OF MICHIGAN
COUNTY OF KENT
RECEIVED FOR RECORD

54 DEC 16 AM 9:23

For corners in
Kent
(County)

COMMISSION

Located In:

Corner Code #


1. Public Land Survey	T	<u>7N</u>	R	<u>11W</u>	I-3 (SE cor, Sec 3)
	T		R		
	T		R		
	T		R		
2. Property Controlling in Section	S		T	R	
	S		T	R	
3. Miscellaneous Property in Sec.	S		T	R	
	S		T	R	

Eric J. Glaza
REG. OF DEEDS

7857

Register of Deeds Stamp & File Number

4. Lot No. _____, Recorded Plat _____
5. Private Claims _____

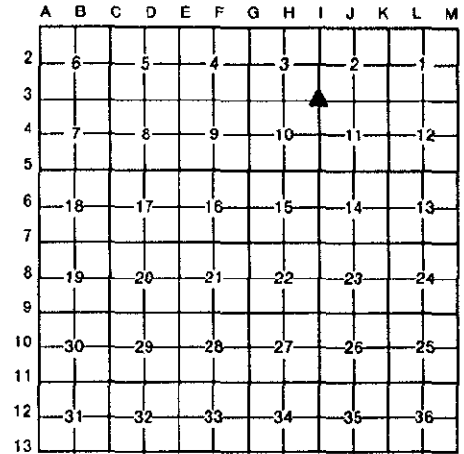

I, James C. Glaza, in a field survey on November 21, 19 94, do hereby certify that under requirements of P.A. 74, Michigan P.A. of 1970, the corner points mentioned in lines 1 and 2 above were in conformance with regulations and rules therefore as required in the current manual of survey instructions of the United States Department of the Interior, Bureau of Land Management or by a decree of a Court of Law and/or that the corner points mentioned in lines 3, 4 and 5 above were in conformance with the rules of the Michigan Board of Land Surveyors or by a Decree of a Court of Law; established, re-established, monumented, re-monumented, recovered, found as expressed below:

NOTE: Not more than 4 corners, all in the same town and range, may be recorded on this certificate.

A. Description of original monument and accessories and/or subsequent restoration:

I-3	1831	G.L.O.	Mullett	set post
	No Date	Kent Co. Wit.	----	iron
	1973	LCRC #381	Spicer	iron
	1978	LCRC #1144	Bonnema	iron
	1982	LCRC #2772	Merdzinski	set Kent Co. Mon.
	1993	LCRC #6740	Roon	set Kent Co. Mon.

The position of this corner was previously approved by the Kent County Remonumentation Peer Group, monumented by John A. Merdzinski on March 9, 1982 and was recorded per LCRC #2772.

B. Description of corner evidence found and/or method applied in restoring or reestablishing corner:

I-3 Found standard Kent Co. Mon. (Harrison) per witnesses from LCRC #6740 as set by Russell L. Roon. Kent Co. Mon. set in 1982 was destroyed due to road construction.

LCRC #6740

Nail & tag in P.P.	S70°W	72.15'
NW corner of C.B. frame	S60°E	48.04'
SW corner of C.B. frame	N70°E	45.21'
SW corner of C.B. frame	N22°E	59.93'

The selected location is accepted by me and is generally accepted by professional surveyors as the best available evidence of the position of the original corner.


C. Description of monument for corner and accessories established to perpetuate locating the position of the corner:

I-3	Standard Kent County Monument		
	Nail & MDOT tag in P.P.	S70°W	72.14'
	NW corner of C.B. frame	S60°E	48.04'
	SW corner of C.B. frame	N70°E	45.25'
	SW corner of C.B. frame	N22°E	59.95'

P.A. 345 1990 KENT COUNTY

PEER APPROVED 10/12/94

CHAIRMAN *Harry Huber*

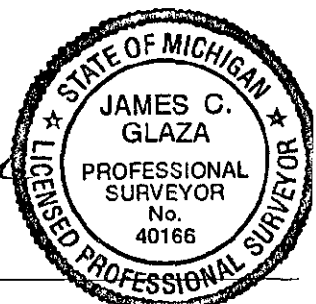

Signed by James C. Glaza
Glaza & Associates, Inc. 40166

Date December 7, 1994