

SURVEY & REMONUMENTATION

\$7.00
\$2.00

APR 28 1995

COMMISSION LAND CORNER RECORDATION CERTIFICATE
Filing Requirement of Act 74, Mich. P.A. 1970

STATE OF MICHIGAN
COUNTY OF KENT
RECEIVED FOR RECORD
94
DEC 16 AM 9:23

For corners in

Kent County Remonumentation

<u>Kent</u> (County)	Located In:	Corner Code #
1. Public Land Survey	T <u>7N</u> R <u>11W</u>	I-7 (SE cor, Sec 15)
	T _____ R _____	_____
	T _____ R _____	_____
	T _____ R _____	_____
2. Property Controlling in Section	S _____ T _____ R _____	_____
	S _____ T _____ R _____	_____
3. Miscellaneous Property in Sec.	S _____ T _____ R _____	_____
	S _____ T _____ R _____	_____

James C. Glaza
REG. OF DEEDS

7861

Register of Deeds Stamp & File Number

4. Lot No. _____, Recorded Plat _____
5. Private Claims _____

I, James C. Glaza, in a field survey on November 28, 19 94, do hereby certify that under requirements of P.A. 74, Michigan P.A. of 1970, the corner points mentioned in lines 1 and 2 above were in conformance with regulations and rules therefore as required in the current manual of survey instructions of the United States Department of the Interior, Bureau of Land Management or by a decree of a Court of Law and/or that the corner points mentioned in lines 3, 4 and 5 above were in conformance with the rules of the Michigan Board of Land Surveyors or by a Decree of a Court of Law; established, re-established, monumented, re-monumented, recovered, found as expressed below:

	A	B	C	D	E	F	G	H	I	J	K	L	M
2	6	5	4	3	2	1							
3													
4	7	8	9	10	11	12							
5													
6	18	17	16	15	14	13							
7													
8	19	20	21	22	23	24							
9													
10	30	29	28	27	26	25							
11													
12	31	32	33	34	35	36							
13													

NOTE: Not more than 4 corners, all in the same town and range, may be recorded on this certificate.

A. Description of original monument and accessories and/or subsequent restoration:

I-7	1831	G.L.O.	Mullett	set post
	1964	Kent Co. Wit.	-----	1" iron
	1973	LCRC #1176	VanKooten	1" iron
	1982	LCRC #2776	Merdzinski	set Kent Co. Mon.
	1993	LCRC #6745	Roon	set Kent Co. Mon.

The position of this corner was previously approved by the Kent County Remonumentation Peer Group, monumented by John A. Merdzinski on March 5, 1982 and was recorded per LCRC #2776.

B. Description of corner evidence found and/or method applied in restoring or reestablishing corner:

I-7 Found standard Kent Co. Mon. (Harrison) per witnesses from LCRC #6745 as set by Russell L. Roon. Kent Co. Mon. set in 1982 was destroyed due to road construction.
LCRC #6745

Chisled "X" on M.H. frame	S55°W	74.64'
Light pole	N48°W	79.35'
NW corner of catch basin	S65°E	56.33'
SW corner of catch basin	N70°E	60.91'

The selected location is accepted by me and is generally accepted by professional surveyors as the best available evidence of the position of the original corner.

C. Description of monument for corner and accessories established to perpetuate locating the position of the corner:


I-7 Standard Kent County Monument

Chisled "X" on M.H. frame	S55°W	74.64'
K.C. remon tag & nail in NE side light pole	N48°W	79.35'
NW corner of catch basin	S65°E	56.33'
SW corner of catch basin	N70°E	60.91'

P.A. 345 1990 KENT COUNTY

PEER APPROVED 10/12/94

CHAIRMAN Harry Huber

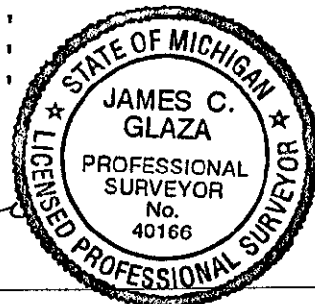

Signed by James C. Glaza
Glaza & Associates, Inc.
Surveyor's Michigan License No. _____

Date December 6, 1994

40166