

SURVEY & REMONUMENTATION

STATE OF MICHIGAN
COUNTY OF KENT
RECEIVED FOR RECORD

APR 28 1995

LAND CORNER RECORDATION CERTIFICATE

Filing Requirement of Act 74, Mich. P.A. 1970

DEC -6 AM 9:05

KENT COUNTY REMONUMENTATION

For corners in

Kent
(County)

COMMISSION

Located in:

Corner Code #

- | | | | |
|------------------------------------|-------------|--------------|------------|
| 1. Public Land Survey | T <u>7N</u> | R <u>11W</u> | <u>1-8</u> |
| | T | R | |
| | T | R | |
| | T | R | |
| 2. Property Controlling in Section | S | T | R |
| | S | T | R |
| 3. Miscellaneous | S | T | R |
| Property in Sec. | S | T | R |

W. J. Bond
REG. OF DEEDS

7821

Register of Deeds Stamp & File Number

4. Lot No. _____, Recorded Plat _____
5. Private Claims _____

I, Randy Kolehouse, in a field survey on June 21 19 94, do hereby certify that under requirements of P.A. 74 Michigan P.A. of 1970, the corner points mentioned in lines 1 and 2 above were in conformance with regulations and rules therefore as required in the current manual of survey instructions of the United States Department of the Interior, Bureau of Land Management or by a decree of a Court of Law and/or that the corner points mentioned in lines 3, 4 and 5 above were in conformance with the rules of the Michigan Board of Land Surveyors or by a Decree of a Court of Law; established, re-established, monumented, re-monumented, recovered, found as expressed below:

NOTE: Not more than 4 corners, all in the same town and range, may be recorded on this certificate.

A	B	C	D	E	F	G	H	I	J	K	L	M
2	6	5	4	3	2	1						
3												
4	7	8	9	10	11	12						
5												
6	16	17	18	15	14	13						
7												
8	19	20	21	22	23	24						
9												
10	29	28	27	26	25							
11												
12	31	32	33	34	35	36						
13												

A. Description of original monument and accessories and/or subsequent restoration:

I-8	1831	G.L.O. Notes	Mullett	Set Post
	1939	Wit. Map	K.C. Surveyor	Iron in Mon. Box
	1972	L.C.R.C. #308	MDOT	Iron in Mon. Box
	1982	L.C.R.C. #2956	Williams & Works	Fnd. Iron in Mon. Box/Set K.C. Mon.

This corner was originally approved by the Kent County Remonumentation Peer Group and monumented by Williams & Works on 3/31/82 and was recorded per L.C.R.C. #2956.

B. Description of corner evidence found and/or method applied in restoring or reestablishing corner:

I-8 Found standard Kent County Monument in C/L Bradford Street running E-W in Southbound East Bellline Avenue per L.C.R.C. #2956 as set by Williams & Works in place of a 1" solid iron in monument box they found which checked L.C.R.C. #308.

L.C.R.C. #2956


Nail & K.C. remon. tag in S side p. pole N 65° W 82.35'

P.A. 345 1990 KENT COUNTY
PEER APPROVED 11/3/99
CHAIRMAN *Harry Spitzer*

The selected location is accepted by me and is generally accepted by professional surveyors as the best available evidence of the position of the original corner.

C. Description of monument for corner and accessories established to perpetuate locating the position of the corner:

- I-8 Standard Kent County Monument
- C/L M.H. N 40° E 64.25'
 - C/L M.H. S 15° E 90.31'
 - C/L M.H. S 75° W 89.12'
 - Nail & K.C. remon. tag S side utl. pole N 60° W 82.31'
 - C/L hyd. N 40° W 92.61'
 - On C/L Bradford E&W 4' E of edge Western most of 2 left turn lanes Southbound East Bellline

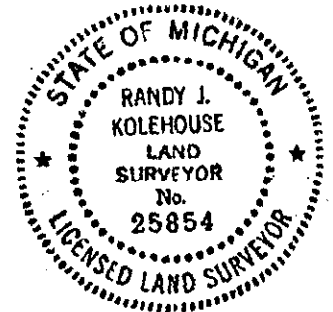

Signed by *Randy J. Kolehouse*

Date 12/1/94

Surveyor's Michigan License No. 25854