

**SURVEY & REMONUMENTATION**

APR 28 1995

**LAND CORNER RECORDATION CERTIFICATE**  
 Filing Requirement of Act 74, Mich. P.A. 1970  
**COMMISSION KENT COUNTY REMONUMENTATION**

STATE OF MICHIGAN  
 COUNTY OF KENT  
 RECEIVED FOR RECORD  
 94 DEC -6 AM 9:05

For corners in

Kent  
 (County)

Located in:

Corner Code #

1. Public Land Survey	T <u>7N</u>	R <u>11W</u>	<u>1-10</u>
	T _____	R _____	_____
	T _____	R _____	_____
	T _____	R _____	_____
2. Property Controlling in Section	S _____	T _____	R _____
	S _____	T _____	R _____
3. Miscellaneous Property in Sec.	S _____	T _____	R _____
	S _____	T _____	R _____

*W. J. Bond*  
 REG. OF DEEDS

**7823**

Register of Deeds Stamp & File Number

4. Lot No. \_\_\_\_\_, Recorded Plat \_\_\_\_\_  
 5. Private Claims \_\_\_\_\_

	A	B	C	D	E	F	G	H	I	J	K	L	V
2	6	5	4	3	2	1							
3													
4	7	8	9	10	11	12							
5													
6	18	17	16	15	14	13							
7													
8	19	20	21	22	23	24							
9													
10	30	29	28	27	26	25							
11													
12	31	32	33	34	35	36							
13													

I, Randy Kolehouse, in a field survey on June 10 19 94, do hereby certify that under requirements of P.A. 74 Michigan P.A. of 1970, the corner points mentioned in lines 1 and 2 above were in conformance with regulations and rules therefore as required in the current manual of survey instructions of the United States Department of the Interior, Bureau of Land Management or by a decree of a Court of Law and/or that the corner points mentioned in lines 3, 4 and 5 above were in conformance with the rules of the Michigan Board of Land Surveyors or by a Decree of a Court of Law, established, re-established, monumented, re-monumented, recovered, found as expressed below:

**NOTE:** Not more than 4 corners, all in the same town and range, may be recorded on this certificate.

A. Description of original monument and accessories and/or subsequent restoration:

I-10	1831	G.L.O. Notes	Mullett	Set Post	P.A. 345 1990 KENT COUNTY
	1930	Wit. Map	K.C. Surveyor	*+ in Pavement	PEER APPROVED <u>10/12/94</u>
	1981	L.C.R.C. #1608	Exxel Engineering	Iron in Mon. Box	CHAIRMAN <u>Hansy Huber</u>
	1982	L.C.R.C. #2955	Williams & Works	Fnd. Iron in Mon. Box/Set K.C. Mon.	
	1992	L.C.R.C. #6385	Marschall	K.C. Monument	

P.A. 345 1990 KENT COUNTY  
 PEER APPROVED 10/12/94  
 CHAIRMAN Hansy Huber

This corner was originally approved by the Kent County Remonumentation Peer Group and monumented by Williams & Works on 3/31/82 and was recorded per L.C.R.C. #2955.

B. Description of corner evidence found and/or method applied in restoring or reestablishing corner:

I-10 Found standard Kent County Monument in C/L of Fulton Avenue running E-W 107' M/L West of C/L Southbound East Beltline Avenue per L.C.R.C.'s #2955 and #6385 as set by Williams & Works in place of an iron in monument box they found which checked the 1930 K.C. Surveyor's records and L.C.R.C. #1608.

L.C.R.C. #2955

L.C.R.C. #6385


Nail & K.C. remon. tag in W side p. pole S 49.11'  
 Nail & K.C. remon. tag in W side p. pole N 15° E 39.42'  
 Nail & K.C. remon. tag in S side 28° Walnut N 70° W 92.88'  
 NW cor. house fdn. S 30° W 87.64'  
 C/L of S bound East Beltline 100' ± E of cor.  
 Corner is in C/L (more or less) Fulton Street

Nail & tag in W side util. pole N 09° E 39.43'  
 Nail & tag in S side Walnut N 70° W 92.83'  
 Nail & tag in W side util. pole S 00° W 49.08'  
 Nail & tag in NE side signal pole S 41° E 96.24'  
 NW cor. house fdn. #3162 S 31° W 87.61  
 C/L of southbound E. Beltline more or less 107.00' E of cor.  
 Corner is in C/L (more or less) of Fulton Street

The selected location is accepted by me and is generally accepted by professional surveyors as the best available evidence of the position of the original corner.

C. Description of monument for corner and accessories established to perpetuate locating the position of the corner:

I-10 Standard Kent County Monument  
 Nail & K.C. remon. tag in W side util. pole N 09° E 39.43'  
 Nail & K.C. remon. tag in S side Walnut N 70° W 92.83'  
 Nail & K.C. remon. tag in W side util. pole S 00° W 49.08'  
 Nail & K.C. remon. tag in NE side signal pole S 41° E 96.24'  
 NW cor. house fdn. #3162 S 31° W 87.61  
 C/L of southbound E. Beltline more or less 107.00' E of cor.  
 Corner is in C/L (more or less) of Fulton Street

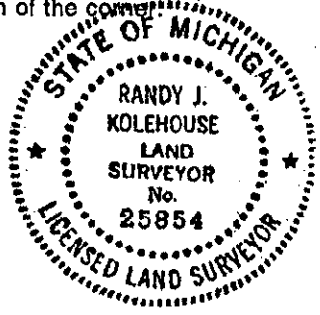

Signed by Randy J. Kolehouse

Date 12/1/94

Surveyor's Michigan License No. 25854