

**SURVEY & REMONUMENTATION**

APR 28 1995

**COMMISSION**

**LAND CORNER RECORDATION CERTIFICATE**  
 Filing Requirement of Act 74, Mich. P.A. 1970  
 KENT COUNTY REMONUMENTATION

STATE OF MICHIGAN  
 COUNTY OF KENT  
 RECEIVED FOR RECORD

94 DEC 29 AM 11:12

For corners in

Kent (County)	Located in:	Corner Code #
1. Public Land Survey	T <u>7N</u> R <u>11W</u>	<u>I-13</u>
	T _____ R _____	_____
	T _____ R _____	_____
	T _____ R _____	_____
2. Property Controlling in Section	S _____ T _____ R _____	_____
	S _____ T _____ R _____	_____
3. Miscellaneous Property in Sec.	S _____ T _____ R _____	_____
	S _____ T _____ R _____	_____

*W. J. Bond*  
 REG. OF DEEDS

7934

Register of Deeds Stamp & File Number

4. Lot No. \_\_\_\_\_, Recorded Plat \_\_\_\_\_  
 5. Private Claims \_\_\_\_\_

I, Randy Kolehouse, in a field survey on March 31 19 94, do hereby certify that under requirements of P.A. 74 Michigan P.A. of 1970, the corner points mentioned in lines 1 and 2 above were in conformance with regulations and rules therefore as required in the current manual of survey instructions of the United States Department of the Interior, Bureau of Land Management or by a decree of a Court of Law and/or that the corner points mentioned in lines 3, 4 and 5 above were in conformance with the rules of the Michigan Board of Land Surveyors or by a Decree of a Court of Law; established, re-established, monumented, re-monumented, recovered, found as expressed below:

**NOTE: Not more than 4 corners, all in the same town and range, may be recorded on this certificate.**

**A. Description of original monument and accessories and/or subsequent restoration:**

I-13	1831	G.L.O. Notes	L. Lyon	Set Post
	1930's	Survey Records	K.C. Surveyor	Wagon Axle
	1959	Survey Records	MDSH	Iron
	1972	L.C.R.C. #298	MDOT	1/2" Iron
	1980	L.C.R.C. #1436	Williams & Works	Fnd. 1/2" Iron/Set K.C. Mon.
	1992	L.C.R.C. #6377	Marschall	K.C. Monument

Standard Note: 10/21/1980 Williams & Works L.C.R.C. #436

**B. Description of corner evidence found and/or method applied in restoring or reestablishing corner:**


I-13 Found Kent County monument on the C/L of Hall Street running West only at the East edge of concrete pavement per L.C.R.C.'s #1436 and #6377 as set by Williams & Works in place of a 1/2' iron pipe they found which checked L.C.R.C. #298.

P.A. 345 1990 KENT COUNTY  
 PEER APPROVED 10/12/94  
 CHAIRMAN *Hans Huber*

The selected location is accepted by me and is generally accepted by professional surveyors as the best available evidence of the position of the original corner.

**C. Description of monument for corner and accessories established to perpetuate locating the position of the corner:**

I-13 Standard Kent County Monument  
 Nail & K.C. remon. tag in S side p. pole N 51° W 53.94'  
 Nail & K.C. remon. tag in S side 10" Tri. Maple N 73° W 122.75'  
 Nail & K.C. remon. tag in E side utl. pole South 30.17'  
 Nail & K.C. remon. tag in N side p. pole East 98.29'  
 C/L top nut on hyd. S 72° W 94.17'  
 On C/L Hall Street pavement running West  
 This corner is common with I-1 T6N R11W

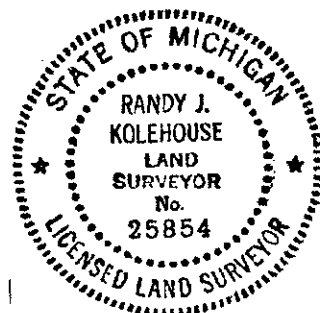

Signed by Randy J. Kolehouse Date 12/20/94  
 Surveyor's Michigan License No. 25854

