

**SURVEY & REMONUMENTATION**

APR 28 1995

COMMISSION

\$7.00  
\$2.00

STATE OF MICHIGAN  
COUNTY OF KENT  
RECEIVED FOR RECORD

94 DEC 16 AM 9:23

**LAND CORNER RECORDATION CERTIFICATE**  
Filing Requirement of Act 74, Mich. P.A. 1970  
Kent County Remonumentation

For corners in

Kent  
(County)

Located In:

Corner Code =#

- |                                    |   |           |   |            |                        |
|------------------------------------|---|-----------|---|------------|------------------------|
| 1. Public Land Survey              | T | <u>7N</u> | R | <u>11W</u> | J-2 (Center,<br>Sec 2) |
|                                    | T |           | R |            |                        |
|                                    | T |           | R |            |                        |
|                                    | T |           | R |            |                        |
| 2. Property Controlling in Section | S |           | T | R          |                        |
|                                    | S |           | T | R          |                        |
| 3. Miscellaneous Property in Sec.  | S |           | T | R          |                        |
|                                    | S |           | T | R          |                        |

*Lucy Bond*

REG. OF DEEDS

7863

Register of Deeds Stamp & File Number

4. Lot No. \_\_\_\_\_, Recorded Plat \_\_\_\_\_  
5. Private Claims \_\_\_\_\_

	A	B	C	D	E	F	G	H	I	J	K	L	M
2	6		5		4		3		▲				
3													
4	7		8		9		10		11		12		
5													
6	18		17		16		15		14		13		
7													
8	19		20		21		22		23		24		
9													
10	30		29		28		27		26		25		
11													
12	31		32		33		34		35		36		
13													

I, James C. Glaza, in a field survey on November 21, 1994, do hereby certify that under requirements of P.A. 74, Michigan P.A. of 1970, the corner points mentioned in lines 1 and 2 above were in conformance with regulations and rules therefore as required in the current manual of survey instructions of the United States Department of the Interior, Bureau of Land Management or by a decree of a Court of Law and/or that the corner points mentioned in lines 3, 4 and 5 above were in conformance with the rules of the Michigan Board of Land Surveyors or by a Decree of a Court of Law; established, re-established, monumented, re-monumented, recovered, found as expressed below:

**NOTE: Not more than 4 corners, all in the same town and range, may be recorded on this certificate.**

**A. Description of original monument and accessories and/or subsequent restoration:**

J-2 This corner was not originally set by the G.L.O.

1907	survey records	Williams & Works	leaded stone
1941	survey records	Williams & Works	replace stone with iron
1945-1947	survey records	Williams & Works	found iron
1974	LCRC #689	Bonnema	found 3/4" iron

**B. Description of corner evidence found and/or method applied in restoring or reestablishing corner:**

J-2 Found 3/4" iron as recorded in 1974 by Douglas Bonnema. This iron is 2.1' North and 8.8' West of the intersection of the 1/4 lines. The Kent County Remonumentation Peer Group approved the iron as the center of section.

LCRC #689

Nail in side 30" Oak	West	34.00'
Nail in side 30" Oak	NW	39.76'
Nail in side 16" W. Cherry	East	31.04'
Nail in side 16" W. Cherry	NE	66.42'


P.A. 345 1993 KENT COUNTY

PEER APPROVED 9/22/94  
CHAIRMAN *Harry Huber*

**C. Description of monument for corner and accessories established to perpetuate locating the position of the corner:**

J-2 Replace 3/4" iron with a standard 4" x 30" Kent County Monument.

Set Nail & K.C. remon tag in N side 30" Oak	N85°W	34.10'
Set Nail & K.C. remon tag in SW side 30" Oak	N45°W	39.79'
Set Nail & K.C. remon tag in NE side P. pole	S50°E	88.97'
Set Nail & K.C. remon tag in NW side 12" Elm	N40°E	59.73'
C/L N-S bit. road 12' E		
C/L concrete drive to house #3184 9' South		

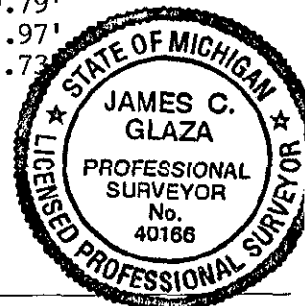

Signed by James C. Glaza  
Glaza & Associates, Inc. 40166  
Surveyor's Michigan License No. \_\_\_\_\_

Date December 12, 1994