

**SURVEY & REMONUMENTATION**  
 \$7.00  
 \$2.00  
 APR 28 1995

STATE OF MICHIGAN  
 COUNTY OF KENT  
 RECEIVED FOR RECORD

**COMMISSION**

**LAND CORNER RECORDATION CERTIFICATE** 94 DEC 16 AM 9:23  
 Filing Requirement of Act 74, Mich. P.A. 1970  
 Kent County Remonumentation

*W. J. Bond*  
 REG. OF DEEDS


For corners in Kent (County) Located In: \_\_\_\_\_ Corner Code # \_\_\_\_\_

1. Public Land Survey	T <u>7N</u> R <u>11W</u>	<u>J-5 (N 1/4 cor, Sec 14)</u>
	T _____ R _____	_____
	T _____ R _____	_____
	T _____ R _____	_____
2. Property Controlling in Section	S _____ T _____ R _____	_____
	S _____ T _____ R _____	_____
3. Miscellaneous Property in Sec.	S _____ T _____ R _____	_____
	S _____ T _____ R _____	_____

4. Lot No. \_\_\_\_\_, Recorded Plat \_\_\_\_\_

5. Private Claims \_\_\_\_\_

**7866**  
 Register of Deeds Stamp & File Number

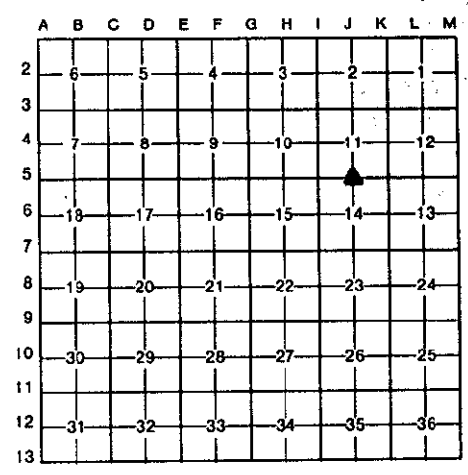

I, James C. Glaza, in a field survey on December 2, 19 94, do hereby certify that under requirements of P.A. 74, Michigan P.A. of 1970, the corner points mentioned in lines 1 and 2 above were in conformance with regulations and rules therefore as required in the current manual of survey instructions of the United States Department of the Interior, Bureau of Land Management or by a decree of a Court of Law and/or that the corner points mentioned in lines 3, 4 and 5 above were in conformance with the rules of the Michigan Board of Land Surveyors or by a Decree of a Court of Law; established, re-established, monumented, re-monumented, recovered, found as expressed below:

**NOTE: Not more than 4 corners, all in the same town and range, may be recorded on this certificate.**

**A. Description of original monument and accessories and/or subsequent restoration:**

J-5	1831	G.L.O.	Mullett	set post
	1961	Kent Co. Wit.	-----	"X" on pavement
	1980	LCRC #2075	Nederveld	iron
	1982	LCRC #2777	Merdzinski	set Kent Co. Mon.
	1991	LCRC #6388	Marschall	Kent Co. Mon.

The position of this corner was previously approved by the Kent County Remonumentation Peer Group, monumented by John A. Merdzinski on March 9, 1982 and was recorded per LCRC #2777.

**B. Description of corner evidence found and/or method applied in restoring or reestablishing corner:**

J-5 Found broken 4"x10" Kent Co. Mon. (Harrison) per witnesses from LCRC #2777 as set by John A. Merdzinski in place of a iron he found and per witnesses from LCRC #6388

LCRC #6388

Nail & tag in NE side 12" Locust	S50°E	50.68'
Nail & tag in NW side P.P.	S65°W	65.77'
SW corner house foundation	N35°E	90.47'
NW corner garage foundation	N45°W	123.10'
Corner is in C/L of E-W road (Knapp)		
Leaded stone	S00°W	32.94'


The selected location is accepted by me and is generally accepted by professional surveyors as the best available evidence of the position of the original corner.

**C. Description of monument for corner and accessories established to perpetuate locating the position of the corner:**

J-5 Replace broken Kent Co. Mon. with 4"x16" Harrison Mon. in mon. box.

Nail & K.C. remon tag in NW side P.P.	S65°W	65.77'
SW corner garage foundation	N40°W	123.13'
Set Nail & K.C. remon tag in S side P.P.	N18°E	40.33'
Set Nail & K.C. remon tag in E side 24" Pine	S09°E	63.12'
Corner is in C/L of E-W road (Knapp)		

P.A. 345 1990 KENT COUNTY  
 PEER APPROVED 10/12/94  
 CHAIRMAN Harry Kubec  
 Date December 8, 1994

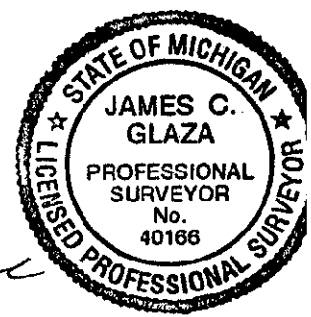

Signed by James C. Glaza  
 Glaza & Associates, Inc. 40166  
 Surveyor's Michigan License No. \_\_\_\_\_