

SURVEY & REMONUMENTATION

APR 28 1995

COMMISSION

LAND CORNER RECORDATION CERTIFICATE
 Filing Requirement of Act 74, Mich. P.A. 1970
 KENT COUNTY REMONUMENTATION

STATE OF MICHIGAN
 COUNTY OF KENT
 RECEIVED FOR RECORD

94 DEC -6 AM 9:05

For corners in


Kent (County)	Located in:	Corner Code #
1. Public Land Survey	T <u>7N</u> R <u>11W</u>	<u>J-13</u>
	T _____ R _____	_____
	T _____ R _____	_____
	T _____ R _____	_____
2. Property Controlling in Section	S _____ T _____ R _____	_____
	S _____ T _____ R _____	_____
3. Miscellaneous Property in Sec.	S _____ T _____ R _____	_____
	S _____ T _____ R _____	_____

W. J. Bond
 REG. OF DEEDS

7827

Register of Deeds Stamp & File Number

4. Lot No. _____, Recorded Plat _____
 5. Private Claims _____

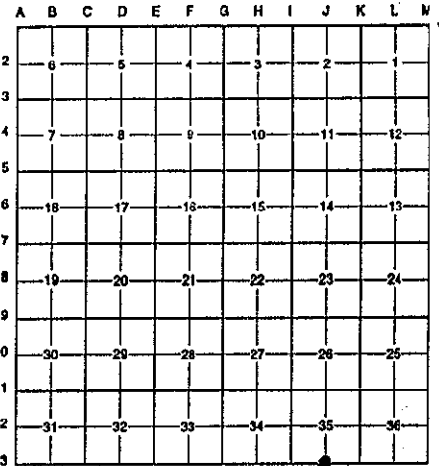

I, Randy Kolehouse, in a field survey on July 20 19 94, do hereby certify that under requirements of P.A. 74 Michigan P.A. of 1970, the corner points mentioned in lines 1 and 2 above were in conformance with regulations and rules therefore as required in the current manual of survey instructions of the United States Department of the Interior, Bureau of Land Management or by a decree of a Court of Law and/or that the corner points mentioned in lines 3, 4 and 5 above were in conformance with the rules of Law and the Michigan Board of Land Surveyors or by a Decree of a Court of Law; established, re-established, monumented, re-monumented, recovered, found as expressed below:

NOTE: Not more than 4 corners, all in the same town and range, may be recorded on this certificate.

A. Description of original monument and accessories and/or subsequent restoration:

J-13	1831	G.L.O. Notes	L. Lyon	Set Post
	1972	L.C.R.C. #302	MDSH	Iron in Stones
	1980	L.C.R.C. #1432	Williams & Works	Fnd. Iron/Set K.C. Mon.
	1991	L.C.R.C. #6375	Marschall	

P.A. 345 1990 KENT COUNTY

PEER APPROVED 11/13/94
 CHAIRMAN *Harvey Huber*

This corner was originally approved by the Kent County Remonumentation Peer Group and monumented by Williams & Works on 10/20/80 and was recorded per L.C.R.C. #1432.

B. Description of corner evidence found and/or method applied in restoring or reestablishing corner:

J-13 Found standard Kent County Monument and stones per L.C.R.C.'s #1432 and #6375 as set by Williams & Works in place of a 3/4" Iron and three stones they found which checked L.C.R.C. #302. This corner is common with J-1 T6N R11W.

L.C.R.C. #1432


L.C.R.C. #6375

- | | |
|---|---|
| Nail & K.C. remon. tag in W side 14" Ash N 40° E 17.25' | Nail & tag N side Triple 12" Basswood S 88° E 2.58' |
| | Nail & tag S side 12" Maple N 75° W 6.05' |
| | Nail & tag S side 10" Basswood S 88° W 32.09' |
| | Nail & tag NW side 12" Ash N 40° E 17.21' |
| | Nail & tag W side 14" Maple N 01° W 21.24' |

The selected location is accepted by me and is generally accepted by professional surveyors as the best available evidence of the position of the original corner.

C. Description of monument for corner and accessories established to perpetuate locating the position of the corner:

- J-13 Standard Kent County Monument
- Nail & K.C. remon. tag N side Triple 12" Basswood S 88° E 2.58'
 - Nail & K.C. remon. tag S side 12" Maple N 75° W 6.05'
 - Nail & K.C. remon. tag S side 10" Basswood S 88° W 32.09'
 - Nail & K.C. remon. tag NW side 12" Ash N 40° E 17.21'
 - Nail & K.C. remon. tag W side 14" Maple N 00° W 21.24'

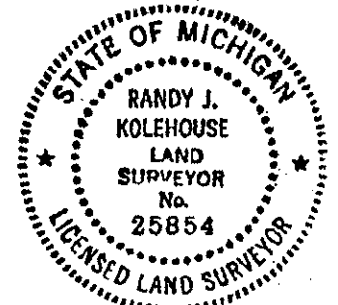

Signed by *Randy J. Kolehouse* Date 12/1/94
 Surveyor's Michigan License No. 25854