

**SURVEY & REMONUMENTATION**

\$7.00  
\$2.00

APR 28 1995

STATE OF MICHIGAN  
COUNTY OF KENT  
RECEIVED FOR RECORD

94 DEC 16 AM 9:24

**COMMISSION**

**LAND CORNER RECORDATION CERTIFICATE**

Filing Requirement of Act 74, Mich. P.A. 1970  
Kent County Remonumentation

For corners in

Kent (County)	Located in:	Corner Code #
1. Public Land Survey	T <u>7N</u> R <u>11W</u>	<u>K-3 (NE cor., Sec 11)</u>
	T _____ R _____	_____
	T _____ R _____	_____
	T _____ R _____	_____
2. Property Controlling in Section	S _____ T _____ R _____	_____
	S _____ T _____ R _____	_____
3. Miscellaneous Property in Sec.	S _____ T _____ R _____	_____
	S _____ T _____ R _____	_____
4. Lot No. _____, Recorded Plat _____		
5. Private Claims _____		

*W. J. Bond*  
REG. OF DEEDS

7871

Register of Deeds Stamp & File Number

I, James C. Glaza, in a field survey on November 21, 19 94, do hereby certify that under requirements of P.A. 74, Michigan P.A. of 1970, the corner points mentioned in lines 1 and 2 above were in conformance with regulations and rules therefore as required in the current manual of survey instructions of the United States Department of the Interior, Bureau of Land Management or by a decree of a Court of Law and/or that the corner points mentioned in lines 3, 4 and 5 above were in conformance with the rules of the Michigan Board of Land Surveyors or by a Decree of a Court of Law, established, re-established, monumented, re-monumented, recovered, found as expressed below:

	A	B	C	D	E	F	G	H	I	J	K	L	M
2	6	5	4	3	2	1							
3													
4	7	8	9	10	11	12							
5													
6	16	17	16	15	14	13							
7													
8	19	20	21	22	23	24							
9													
10	30	29	28	27	26	25							
11													
12	31	32	33	34	35	36							
13													

**NOTE: Not more than 4 corners, all in the same town and range, may be recorded on this certificate.**

**A. Description of original monument and accessories and/or subsequent restoration:**

K-3	1831	G.L.O.	Mullett	set post
	No Date	Kent Co. Wit.	-----	iron over stone
	1977	LCRC #1104	Merdzinski	iron
	1978	LCRC #1194	Shangraw	iron
	1982	LCRC #2780	Merdzinski	set Kent Co. Mon.
	1984	LCRC #3993	Kolehouse	replace broken Kent Co. Mon.
	1991	LCRC #6393	Marschall	Kent County Monument

The position of this corner was previously approved by the Kent County Remonumentation Peer Group, monumented by John A. Merdzinski on March 4, 1982 and was recorded per LCRC #2780.

**B. Description of corner evidence found and/or method applied in restoring or reestablishing corner:**

K-3 Found standard Kent Co. Mon. (Harrison) per witnesses from LCRC #3993 as set by Randy J. Kolehouse in place of broken Harrison Monument he found, and per witnesses from LCRC #6393.

LCRC #6393	SW corner of stone porch (at base of siding)	N10°W	40.86'
	K.C. remon tag & nail in W side 22" Oak	N38°W	69.30'
	K.C. remon tag & nail in E side 24" Oak	N22°E	39.33'
	K.C. remon tag & nail in S side 48" Willow	N58°E	66.88'
	K.C. remon tag & nail in W side 6" Triple Elm	S30°E	59.61'

C/L Three Mile Rd. is more or less 3' South  
C/L Maguire Ave. is more or less 14' West


The selected location is accepted by me and is generally accepted by professional surveyors as the best available evidence of the position of the original corner.

**C. Description of monument for corner and accessories established to perpetuate locating the position of the corner:**

K-3	Standard Kent County Monument		
	SW corner of stone porch (at base of siding)	N10°W	40.86
	K.C. remon tag & nail in W side 22" Oak	N38°W	69.30'
	K.C. remon tag & nail in E side 24" Oak	N22°E	39.33'
	K.C. remon tag & nail in S side 48" Willow	N58°E	66.88'
	K.C. remon tag & nail in W side 8" Triple Elm	S30°E	59.50'

C/L Three Mile Rd. is more or less 3' South  
C/L Maguire Ave. is more or less 14' West

P.A. 345 1990 KENT COUNTY  
PEER APPROVED 10/12/94  
CHAIRMAN Randy Kolehouse

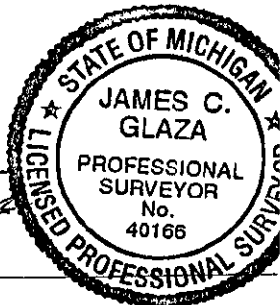

Signed by James C. Glaza  
Glaza & Associates, Inc.  
Surveyor's Michigan License No. 40166

Date December 5, 1994