

\$7.00
\$2.00

APR 28 1995

LAND CORNER RECORDATION CERTIFICATE

Filing Requirement of Act 74, Mich. P.A. 1970
Kent County Remonumentation

STATE OF MICHIGAN
COUNTY OF KENT
RECEIVED FOR RECORD

DEC 16 AM 9:24

COMMISSION

For corners in

Kent (County)	Located In:	Corner Code #
1. Public Land Survey	T <u>7N</u> R <u>11W</u>	<u>K-7 (SW cor, Sec 13)</u>
	T _____ R _____	_____
	T _____ R _____	_____
	T _____ R _____	_____
2. Property Controlling in Section	S _____ T _____ R _____	_____
	S _____ T _____ R _____	_____
3. Miscellaneous Property in Sec.	S _____ T _____ R _____	_____
	S _____ T _____ R _____	_____

Tim J. Glaza
REG. OF DEEDS

7875

Register of Deeds Stamp & File Number

- 4. Lot No. _____, Recorded Plat _____
- 5. Private Claims _____

	A	B	C	D	E	F	G	H	I	J	K	L	M
2	6	5	4	3	2	1							
3													
4	7	8	9	10	11	12							
5													
6	18	17	16	15	14	13							
7													
8	19	20	21	22	23	24							
9													
10	30	29	28	27	26	25							
11													
12	31	32	33	34	35	36							
13													

I, James C. Glaza, in a field survey on November 25, 19 94, do hereby certify that under requirements of P.A. 74, Michigan P.A. of 1970, the corner points mentioned in lines 1 and 2 above were in conformance with regulations and rules therefore as required in the current manual of survey instructions of the United States Department of the Interior, Bureau of Land Management or by a decree of a Court of Law and/or that the corner points mentioned in lines 3, 4 and 5 above were in conformance with the rules of the Michigan Board of Land Surveyors or by a Decree of a Court of Law; established, re-established, monumented, re-monumented, recovered, found as expressed below:

NOTE: Not more than 4 corners, all in the same town and range, may be recorded on this certificate.

A. Description of original monument and accessories and/or subsequent restoration:

K-7	1831	G.L.O.	Mullett	set post
	1972	Kent Co. Wit.	-----	iron
	1972	LCRC #170	Bonnema	iron
	1982	LCRC #2783	Merdzinski	set Kent Co. Mon.
	1992	LCRC #6397	Marschall	Kent Co. Mon.

The position of this corner was previously approved by the Kent County Remonumentation Peer Group, monumented by John A. Merdzinski on March 4, 1982 and was recorded per LCRC #2783.

B. Description of corner evidence found and/or method applied in restoring or reestablishing corner:

K-7 Found standard Kent Co. Mon. (Harrison) per witnesses from LCRC #2783 as set by John A. Merdzinski in place of the 3/4" iron he found and per witnesses from LCRC #6397.

LCRC #6397

Nail & tag in East side utility pole	S05°E	27.76'
Nail & tag in East side guy pole	N03°E	23.86'
Corner J-7	S88°30'56"W	2687.01'
Corner L-7	S88°30'56"E	2665.23'

The selected location is accepted by me and is generally accepted by professional surveyors as the best available evidence of the position of the original corner.

C. Description of monument for corner and accessories established to perpetuate locating the position of the corner:


K-7 Standard Kent County Monument

Nail & K.C. remon tag in East side utility pole	S05°E	27.76'
Nail & K.C. remon tag in East side guy pole	N03°E	23.88'
Corner J-7	S90°W	2686.98'
Corner L-7	N90°E	2665.26'

P.A. 345 1990 KENT COUNTY

PEER APPROVED *12/12/99*

CHAIRMAN *Henry Huber*

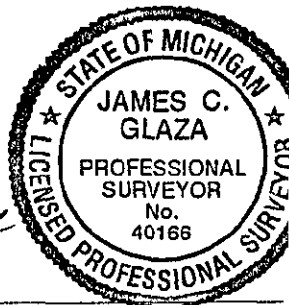

Signed by *James C. Glaza*

Date December 7, 1994

Surveyor's Michigan License No. 40166