

SURVEY & REMONUMENTATION

APR 28 1995

LAND CORNER RECORDATION CERTIFICATE Filing Requirement of Act 74, Mich. P.A. 1970 KENT COUNTY REMONUMENTATION

STATE OF MICHIGAN
COUNTY OF KENT
RECEIVED FOR RECORD

DEC -6 AM 9:05

For corners in COMMISSION

For corners in	Kent (County)	Located in:	Corner Code #
1. Public Land Survey	T <u>7N</u>	R <u>11W</u>	<u>K-9</u>
	T _____	R _____	_____
	T _____	R _____	_____
	T _____	R _____	_____
2. Property Controlling in Section	S _____	T _____	R _____
	S _____	T _____	R _____
3. Miscellaneous Property in Sec.	S _____	T _____	R _____
	S _____	T _____	R _____

W. J. Cole
REG. OF DEEDS

7829

Register of Deeds Stamp & File Number

4. Lot No. _____, Recorded Plat _____
5. Private Claims _____

I, Randy Kolehouse, in a field survey on June 10 19 94, do hereby certify that under requirements of P.A. 74 Michigan P.A. of 1970, the corner points mentioned in lines 1 and 2 above were in conformance with regulations and rules therefore as required in the current manual of survey instructions of the United States Department of the Interior, Bureau of Land Management or by a decree of a Court of Law and/or that the corner points mentioned in lines 3, 4 and 5 above were in conformance with the rules of the Michigan Board of Land Surveyors or by a Decree of a Court of Law; established, re-established, monumented, re-monumented, recovered, found as expressed below:

	A	B	C	D	E	F	G	H	I	J	K	L	M
2	6	5	4	3	2	1							
3													
4	7	8	9	10	11	12							
5													
6	18	17	16	15	14	13							
7													
8	19	20	21	22	23	24							
9													
10	30	29	28	27	26	25							
11													
12	31	32	33	34	35	36							
13													

NOTE: Not more than 4 corners, all in the same town and range, may be recorded on this certificate.

A. Description of original monument and accessories and/or subsequent restoration:

K-9	1831	G.L.O. Notes	Mullett	Set Post
	N/A	Wit. Map	K.C. Surveyor	Iron Between Stones
	1975	L.C.R.C. #868	Medema Van Kooten	"T" Iron
	1982	L.C.R.C. #3277	C. Hay	Fnd. Iron/Set K.C. Mon.
	1991	L.C.R.C. #6399	Marschall	K.C. Mon.

This corner was originally approved by the Kent County Remonumentation Peer Group and monumented by Clayton S. Hay on 3/10/82 and was recorded per L.C.R.C. #3277 and also recorded on 12/18/92 per L.C.R.C. #6399.

B. Description of corner evidence found and/or method applied in restoring or reestablishing corner:

K-9 Found standard Kent County Monument in Michigan Street running E-W per L.C.R.C.'s #3277 and #6399 as set by C. Hay in place of a "T" iron over a 3/4" iron in stones he found which checked K.C. Surveyor records and L.C.R.C. #868.

L.C.R.C. #3277

NE cor. bottom step to porch S 20° W 60.80'
W side of 20" Spruce S 33.92'
E side of 12" Spruce S 23° W 56.77'

L.C.R.C. #6399


Nail & tag S side p. pole N 80° W 113.45'
Nail & tag N side p. pole S 75° W 102.65'
Nail & tag W side 24" Spruce S 01° W 33.86'
Nail & tag E side 14" Spruce S 19° W 56.65'
NE cor. bott. conc. step to porch S 16° W 60.71'

The selected location is accepted by me and is generally accepted by professional surveyors as the best available evidence of the position of the original corner.

C. Description of monument for corner and accessories established to perpetuate locating the position of the corner:

K-9 Standard Kent County Monument
Nail & K.C. remon. tag in S side p. pole N 80° W 113.45'
Nail & K.C. remon. tag in N side p. pole S 75° W 102.65'
Nail & K.C. remon. tag in W side 24" Spruce S 01° W 33.86'
Nail & K.C. remon. tag in E side 14" Spruce S 19° W 56.65'
Nail & K.C. remon. tag in E side 12" stump N 05° W 22.55'
NE cor. bott. conc. step to porch S 16° W 60.71'

P.A. 345 1990 KENT COUNTY
PEER APPROVED 10/12/94
CHAIRMAN *[Signature]*

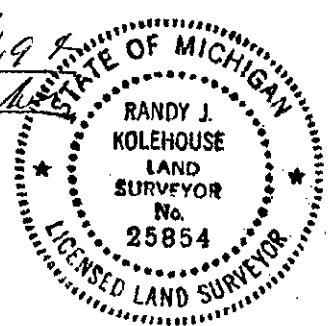

Signed by Randy J. Kolehouse
Surveyor's Michigan License No. 25854

Date 12/1/94