

**SURVEY & REMONUMENTATION**

APR 28 1995

STATE OF MICHIGAN  
COUNTY OF KENT  
RECEIVED FOR RECORD

COMMISSION

**LAND CORNER RECORDATION CERTIFICATE**

Filing Requirement of Act 74, Mich. P.A. 1970  
KENT COUNTY REMONUMENTATION

DEC -6 AM 9:05

For corners in

Kent (County)	Located in:	Corner Code #
1. Public Land Survey	T <u>7N</u> R <u>11W</u>	<u>K-10</u>
	T _____ R _____	_____
	T _____ R _____	_____
	T _____ R _____	_____
2. Property Controlling in Section	S _____ T _____ R _____	_____
	S _____ T _____ R _____	_____
3. Miscellaneous Property in Sec.	S _____ T _____ R _____	_____
	S _____ T _____ R _____	_____

*W. J. Bond*  
REG. OF DEEDS

7830

Register of Deeds Stamp & File Number

4. Lot No. \_\_\_\_\_, Recorded Plat \_\_\_\_\_  
5. Private Claims \_\_\_\_\_

	A	B	C	D	E	F	G	H	I	J	K	L	M
2	6	5	4	3	2	1							
3													
4	7	8	9	10	11	12							
5													
6	16	17	18	19	20	21	22	23	24				
7													
8	19	20	21	22	23	24							
9													
10	30	29	28	27	26	25							
11													
12	31	32	33	34	35	36							
13													

I, Randy Kolehouse, in a field survey on July 25 19 94, do hereby certify that under requirements of P.A. 74 Michigan P.A. of 1970, the corner points mentioned in lines 1 and 2 above were in conformance with regulations and rules therefore as required in the current manual of survey instructions of the United States Department of the Interior, Bureau of Land Management or by a decree of a Court of Law and/or that the corner points mentioned in lines 3, 4 and 5 above were in conformance with the rules of the Michigan Board of Land Surveyors or by a Decree of a Court of Law; established, re-established, monumented, re-monumented, recovered, found as expressed below:

**NOTE:** Not more than 4 corners, all in the same town and range, may be recorded on this certificate.

**A. Description of original monument and accessories and/or subsequent restoration:**

K-10	1831	G.L.O. Notes	Mullett	Set Post
	N/A	Wit. Map	K.C. Surveyor	Iron
	1971	L.C.R.C. #23	MDOT	1/2" Iron Pipe
	1980	L.C.R.C. #1476	Williams & Works	Fnd. 1/2" Iron Pipe/Set K.C. Mon.
	1991	L.C.R.C. #6400	Marschall	K.C. Monument

P.A. 345 1990 KENT COUNTY  
PEER APPROVED 11/3/94  
CHAIRMAN *[Signature]*

This corner was originally approved by the Kent County Remonumentation Peer Group and monumented by Williams & Works on 10/31/80 and was recorded per L.C.R.C. #1476.

**B. Description of corner evidence found and/or method applied in restoring or reestablishing corner:**

K-10 Found standard Kent County Monument per L.C.R.C. #1476 and #6400 as set by Williams & Works in place of a 1/2" iron pipe they found which checked L.C.R.C. #23 and K.C. Surveyor's records.

L.C.R.C. #1476

L.C.R.C. #6400


Nail & K.C.R. tag in E side 4" Cedar N 30° E 13.33'  
1/2 iron pipe S 05° E 18.10'

Nail & tag SW side 6" Cedar S 35° E 7.74'  
Nail & tag SE side 6" Cedar N 30° E 13.25'  
Nail & tag E side 4" Ash N 10° W 6.44'  
1/2" iron pipe S 05° E 18.10'  
Mon. is more or less 12' W of tennis court  
Mon. is more or less 600' N of C/L M-21 (Fulton St.)

The selected location is accepted by me and is generally accepted by professional surveyors as the best available evidence of the position of the original corner.

**C. Description of monument for corner and accessories established to perpetuate locating the position of the corner:**

K-10 Standard Kent County Monument  
Nail & K.C. remon. tag SW side 6" Cedar S 35° E 7.74'  
Nail & K.C. remon. tag SE side 6" Cedar N 30° E 13.25'  
Nail & K.C. remon. tag E side 4" Ash N 10° W 6.44'  
1/2" iron pipe S 05° E 18.10'  
Mon. is more or less 12' W of tennis court  
Mon. is more or less 600' N of C/L M-21 (Fulton St.)

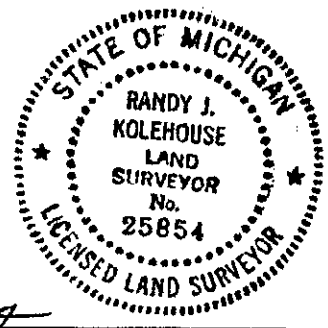

Signed by Randy J. Kolehouse  
Surveyor's Michigan License No. 25854

Date 12/1/99