

**SURVEY & REMONUMENTATION**

\$7.00  
\$2.00 APR 28 1995

STATE OF MICHIGAN  
COUNTY OF KENT  
RECEIVED FOR RECORD

**LAND CORNER RECORDATION CERTIFICATE**

Filing Requirement of Act 74, Mich. P.A. 1970  
Kent County Remonumentation

94 DEC 16 AM 9:24

**COMMISSION**

For corners in

Kent

(County)

Located in:

Corner Code #

- 1. Public Land Survey T 7N R 11W
- T \_\_\_\_\_ R \_\_\_\_\_
- T \_\_\_\_\_ R \_\_\_\_\_
- T \_\_\_\_\_ R \_\_\_\_\_
- 2. Property Controlling S \_\_\_\_\_ T \_\_\_\_\_ R \_\_\_\_\_
- in Section S \_\_\_\_\_ T \_\_\_\_\_ R \_\_\_\_\_
- 3. Miscellaneous S \_\_\_\_\_ T \_\_\_\_\_ R \_\_\_\_\_
- Property in Sec. S \_\_\_\_\_ T \_\_\_\_\_ R \_\_\_\_\_

L-1 (N 1/2 cor,  
Sec 1)  
(common corner)

*W. J. Glaza*  
REG. OF DEEDS

7876

Register of Deeds Stamp & File Number

- 4. Lot No. \_\_\_\_\_, Recorded Plat \_\_\_\_\_
- 5. Private Claims \_\_\_\_\_

	A	B	C	D	E	F	G	H	I	J	K	L	M
2	6	5	4	3	2	1							
3													
4	7	8	9	10	11	12							
5													
6	16	17	16	15	14	13							
7													
8	19	20	21	22	23	24							
9													
10	30	29	28	27	26	25							
11													
12	31	32	33	34	35	36							
13													

I, James C. Glaza, in a field survey on November 21, 19 94

do hereby certify that under requirements of P.A. 74, Michigan P.A. of 1970, the corner points mentioned in lines 1 and 2 above were in conformance with regulations and rules therefore as required in the current manual of survey instructions of the United States Department of the Interior, Bureau of Land Management or by a decree of a Court of Law and/or that the corner points mentioned in lines 3, 4 and 5 above were in conformance with the rules of the Michigan Board of Land Surveyors or by a Decree of a Court of Law; established, re-established, monumented, re-monumented, recovered, found as expressed below:

**NOTE: Not more than 4 corners, all in the same town and range, may be recorded on this certificate.**

**A. Description of original monument and accessories and/or subsequent restoration:**

L-1	Not set by G.L.O.		
1971	Kent Co. Wit.	-----	concrete mon.
1981	LCRC #1424	Shangraw	iron
1982	LCRC #3177	Jonker	set Kent Co. Mon.
1988	LCRC #4881	Bueche	Kent Co. Mon.

The position of this corner was previously approved by the Kent County Remonumentation Peer Group, monumented by Robert J. Jonker on November 10, 1982 and was recorded per LCRC #3177.

**B. Description of corner evidence found and/or method applied in restoring or reestablishing corner:**

L-1 Found standard Kent Co. Mon. (Harrison) per witnesses from LCRC # 3177 as set by Robert J. Jonker in place of the concrete monument he found and per witnesses from LCRC #4881.

LCRC #4881

K.C. remon tag & nail in W side 26" W. Cherry	N10°E	61.70'
K.C. remon tag & nail in SE side 32" Maple	N30°E	69.10'
K.C. remon tag & nail in N side 10" Poplar	N50°W	63.10'
K.C. remon tag & nail in E side 12" Oak	S25°E	75.36'
NE corner house foundation	S40°W	117.48'

Witness P.K. nails 3' S & 3' W

On C/L of pavement from West, at East end pavement

The selected location is accepted by me and is generally accepted by professional surveyors as the best available evidence of the position of the original corner.

**C. Description of monument for corner and accessories established to perpetuate locating the position of the corner:**

L-1 Standard Kent County Monument


Set K.C. remon tag & nail in W side 26" W. Cherry	N10°E	60.96'
Set K.C. remon tag & nail in SE side 38" Maple	N30°E	69.51'
NE corner house foundation	S50°W	117.17'
Set K.C. remon tag & nail in SW side P. pole	S20°E	15.50'
On C/L of pavement from West, at East end pavement		

P.A. 345 1990 KENT COUNTY

PEER APPROVED *10/12/94*

CHAIRMAN *Harvey Huber*

Date December 9, 1994

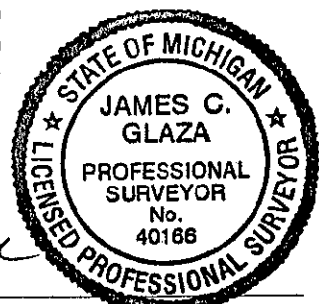

Signed by *James C. Glaza*  
Glaza & Associates, Inc.

Surveyor's Michigan License No. 40166