

SURVEY & REMONUMENTATION

APR 28 1995

COMMISSION

LAND CORNER RECORDATION CERTIFICATE
 Filing Requirement of Act 74, Mich. P.A. 1970
 KENT COUNTY REMONUMENTATION

STATE OF MICHIGAN
 COUNTY OF KENT
 RECEIVED FOR RECORD

94 DEC 29 AM 11:13

Lucy Bond
 REG. OF DEEDS


7963

Register of Deeds Stamp & File Number

For corners in

Kent (County)	Located in:	Corner Code #
1. Public Land Survey	T <u>7N</u> R <u>11W</u>	<u>L-8</u>
	T _____ R _____	_____
	T _____ R _____	_____
	T _____ R _____	_____
2. Property Controlling in Section	S _____ T _____ R _____	_____
	S _____ T _____ R _____	_____
3. Miscellaneous Property in Sec.	S _____ T _____ R _____	_____
	S _____ T _____ R _____	_____

4. Lot No. _____, Recorded Plat _____
 5. Private Claims _____

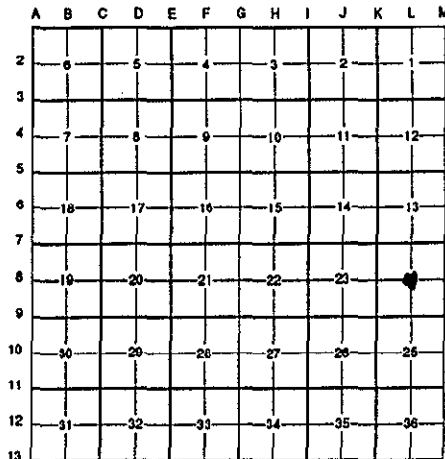

I, Randy Kolehouse, in a field survey on June 20 19 94, do hereby certify that under requirements of P.A. 74 Michigan P.A. of 1970, the corner points mentioned in lines 1 and 2 above were in conformance with regulations and rules therefore as required in the current manual of survey instructions of the United States Department of the interior, Bureau of Land Management or by a decree of a Court of Law and/or that the corner points mentioned in lines 3, 4 and 5 above were in conformance with the rules of the Michigan Board of Land Surveyors or by a Decree of a Court of Law; established, re-established, monumented, re-monumented, recovered, found as expressed below:

NOTE: Not more than 4 corners, all in the same town and range, may be recorded on this certificate.

A. Description of original monument and accessories and/or subsequent restoration:

L-8 This corner was not originally set by the G.L.O.

1953-1966	Survey Records	Williams & Works	Iron
1966-1978	Survey Records	Williams & Works	Mon. Box
1977	L.C.R.C. #1073	Exxel Engineering	1/2" Iron
1978	L.C.R.C. #1129	Williams & Works	1" Iron
1990	L.C.R.C. #5710-A	Bueche	Set Capped Iron

B. Description of corner evidence found and/or method applied in restoring or reestablishing corner:

L-8 Found JCB capped iron at Bradford Street and Crahen Avenue which checks L.C.R.C. #5710-A and Williams & Works 1953-1978 survey records. Capped iron is 1.4' East of N-S 1/4 line and 0.3' South of E-W line. Accepted capped iron as Center Section.


P.A. 345 1990 KENT COUNTY
 PEER APPROVED 11/17/94
 CHAIRMAN *Henry Fisher*

The selected location is accepted by me and is generally accepted by professional surveyors as the best available evidence of the position of the original corner.

C. Description of monument for corner and accessories established to perpetuate locating the position of the corner:

L-8 Replaced capped iron with a Standard 4" x 30" Kent County Monument.

- Nail & K.C. remon. tag in SW side 14" Cedar N 30° W 62.60'
- Nail & K.C. remon. tag in SW side 10" Pine N 55° E 88.73'
- Nail & K.C. remon. tag in SE cor. 6" x 6" post N 50° E 57.16'
- P.K. in SW side lt. pole S 35° E 51.10'
- Top C/L hyd. S 60° W 47.38'

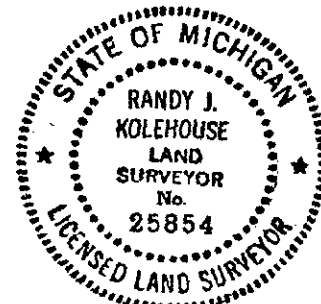

Signed by Randy J. Kolehouse Date 12/12/94
 Surveyor's Michigan License No. 25854