SURVEY & REMONUMENTATION

$7.00
$2.00

APR 28 1995

COMMISSION

STATE OF MICHIGAN
COUNTY OF KENT
RECEIVED FOR RECORD
94 DEC 16 AM 9:24

REG. OF DEEDS

LAND CORNER RECORDATION CERTIFICATE

Filing Requirement of Act 74, Mich. P.A. 1970
Kent County Remonumentation

For corners in Kent (County)

	Located In:	Corner Code #
1. Public Land Survey	T 7N R 11W	M-1 (NE cor, Sec 1)
	T ___ R ___	(common corner)
	T ___ R ___	
	T ___ R ___	
2. Property Controlling	S ___ T ___ R ___	
in Section	S ___ T ___ R ___	
3. Miscellaneous	S ___ T ___ R ___	
Property in Sec.	S ___ T ___ R ___	

7883
Register of Deeds Stamp & File Number

4. Lot No. _____, Recorded Plat _____
5. Private Claims _____

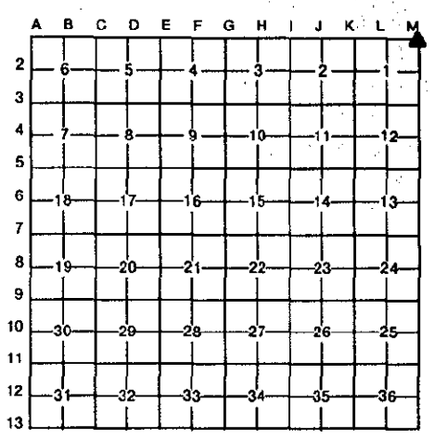

I, James C. Glaza, in a field survey on December 2, 19 94, do hereby certify that under requirements of P.A. 74, Michigan P.A. of 1970, the corner points mentioned in lines 1 and 2 above were in conformance with regulations and rules therefore as required in the current manual of survey instructions of the United States Department of the Interior, Bureau of Land Management or by a decree of a Court of Law and/or that the corner points mentioned in lines 3, 4 and 5 above were in conformance with the rules of the Michigan Board of Land Surveyors or by a Decree of a Court of Law; established, re-established, monumented, re-monumented, recovered, found as expressed below:

NOTE: Not more than 4 corners, all in the same town and range, may be recorded on this certificate.

A. Description of original monument and accessories and/or subsequent restoration:

M-1	1831	G.L.O.	Lyon	set post
	1974	Kent Co. Wit.	----	iron
	1974	LCRC #778	Nederveld	iron
	1981	LCRC #1775	Merdzinski	set Kent Co. Mon.
	1988	LCRC #4892	Bueche	Kent Co. Mon.

P.A. 345 1990 KENT COUNTY PEER APPROVED 10/12/94 CHAIRMAN

The position of this corner was previously approved by the Kent County Remonumentation Peer Group, monumented by John A. Merdzinski on January 28, 1981 and was recorded per LCRC #1775.

B. Description of corner evidence found and/or method applied in restoring or reestablishing corner:

M-1 Found standard Kent Co. Mon. (Harrison) per witnesses from LCRC #1775 as set by John A. Merdzinski in place of a 1" iron he found and per witnesses from LCRC #4892.

LCRC #4892

Nail & K.C. remon tag in S side 12" Maple	N85°E	14.10'
Nail & K.C. remon tag in SW side 14" Poplar	S25°E	26.64'
Nail & K.C. remon tag in S side 12" Poplar	S55°W	33.95'
Nail & K.C. remon tag in NE side 12" Poplar	N75°W	23.29'
Nail & K.C. remon tag in SW side 16" Oak	N35°W	37.74'
Nail & K.C. remon tag in SE side 8" Apple	N15°E	24.04'

C/L Grand River Drive E 430' m/l, W of house #3605

The selected location is accepted by me and is generally accepted by professional surveyors as the best available evidence of the position of the original corner.

C. Description of monument for corner and accessories established to perpetuate locating the position of the corner:

M-1 Standard Kent County Monument

Nail & K.C. remon tag in S side 12" Maple	N85°E	14.21'
Nail & K.C. remon tag in SW side 14" Poplar	S25°E	26.63'
Nail & K.C. remon tag in S side 14" Poplar	S55°W	33.95'
Nail & K.C. remon tag in NE side 16" Poplar	N75°W	23.22'
Nail & K.C. remon tag in SW side 16" Oak	N35°W	31.65'
Nail & K.C. remon tag in SE side 8" Apple	N15°E	24.12'

C/L Grand River Drive E 430' m/l, W of house #3605

STATE OF MICHIGAN
JAMES C. GLAZA
PROFESSIONAL SURVEYOR
No. 40166
LICENSED PROFESSIONAL SURVEYOR

Signed by James C. Glaza Date December 8, 1994
Glaza & Associates, Inc.
Surveyor's Michigan License No. 40166

FORM APPROVED BY MICHIGAN STATE BOARD OF LAND SURVEYORS, JAN. 28, 1971
REVISED MAY 14, 1975
REVISED JAN., 1983