

**SURVEY & REMONUMENTATION**

\$7.00  
\$2.00

APR 28 1995

**LAND CORNER RECORDATION CERTIFICATE**

Filing Requirement of Act 74, Mich. P.A. 1970  
Kent County Remonumentation

STATE OF MICHIGAN  
COUNTY OF KENT  
RECEIVED FOR RECORD

94 DEC 16 AM 9:24

*W. J. Bond*  
REG. OF DEEDS

For corners in  
Kent

**COMMISSION**

Located in:

Corner Code #

- |                                       |                          |   |
|---------------------------------------|--------------------------|---|
| 1. Public Land Survey                 | T <u>7N</u> R <u>11W</u> | M-4 (E 1/4 cor,<br>Sec 12)<br>(common corner) |
|                                       | T _____ R _____          |   |
|                                       | T _____ R _____          |   |
|                                       | T _____ R _____          |   |
| 2. Property Controlling<br>in Section | S _____ T _____ R _____  |   |
|                                       | S _____ T _____ R _____  |   |
| 3. Miscellaneous<br>Property in Sec.  | S _____ T _____ R _____  |   |
|                                       | S _____ T _____ R _____  |   |
4. Lot No. \_\_\_\_\_, Recorded Plat \_\_\_\_\_
5. Private Claims \_\_\_\_\_

7886

Register of Deeds Stamp & File Number

	A	B	C	D	E	F	G	H	I	J	K	L	M
2	6	5	4	3	2	1							
3													
4	7	8	9	10	11	12							
5													
6	18	17	16	15	14	13							
7													
8	19	20	21	22	23	24							
9													
10	30	29	28	27	26	25							
11													
12	31	32	33	34	35	36							
13													

I, James C. Glaza, in a field survey on November 28, 1994, do hereby certify that under requirements of P.A. 74, Michigan P.A. of 1970, the corner points mentioned in lines 1 and 2 above were in conformance with regulations and rules therefore as required in the current manual of survey instructions of the United States Department of the Interior, Bureau of Land Management or by a decree of a Court of Law and/or that the corner points mentioned in lines 3, 4 and 5 above were in conformance with the rules of the Michigan Board of Land Surveyors or by a Decree of a Court of Law; established, re-established, monumented, re-monumented, recovered, found as expressed below:

**NOTE: Not more than 4 corners, all in the same town and range, may be recorded on this certificate.**

A. Description of original monument and accessories and/or subsequent restoration:

M-4	1831	G.L.O.	Lyon	set post
	No Date	Kent Co. Wit.	-----	iron
	1977	LCRC #1024	McCloskey	iron
	1977	LCRC #1056	Glaza	iron
	1981	LCRC #2146	Jonker	set Kent Co. Mon.
	1991	LCRC #6410	Marschall	Kent Co. Mon.

The position of this corner was previously approved by the Kent County Remonumentation Peer Group, monumented by Robert Jonker on August 25, 1981 and was recorded per LCRC #2146.

B. Description of corner evidence found and/or method applied in restoring or reestablishing corner:

M-4 Found standard Kent Co. Mon. (Harrison) per witnesses from LCRC #2146 as set by Robert Jonker in place of a 3/4" iron he found and per witnesses from LCRC #6410.

LCRC #6410

Nail & tag in E side	12" Elm	N05°E	18.51'
Nail & tag in E side	P.P. (7' above ground)	N43°W	55.07'
Nail & tag in W side	fence post (2x6)	S25°E	11.12'
Nail & tag in E side	10" W. Cherry (4' above grd.)	S16°W	51.67'
Nail & tag in SE side	6" W. Cherry (3' above grd.)	S40°W	22.26'

On C/L N-S old fence & brush row and 6' W of N-S fence  
C/L Knapp Street South 183' more or less

The selected location is accepted by me and is generally accepted by professional surveyors as the best available evidence of the position of the original corner.


C. Description of monument for corner and accessories established to perpetuate locating the position of the corner:

M-4 Standard Kent County Monument

Nail & K.C. remon tag in E side	12" Elm	N05°E	18.53'
Nail & K.C. remon tag in E side	P.P. (7' abv. grd.)	N43°W	55.07'
Nail & K.C. remon tag in W side	fence post (2x6)	S25°E	11.12'
Set Nail & K.C. remon tag in W side	fence post (2x6)	N65°E	7.21'

On C/L N-S old fence & brush row and 6' W of N-S fence  
C/L Knapp Street South 183' more or less

Signed by James C. Glaza  
Glaza & Associates, Inc.  
Surveyor's Michigan License No. \_\_\_\_\_

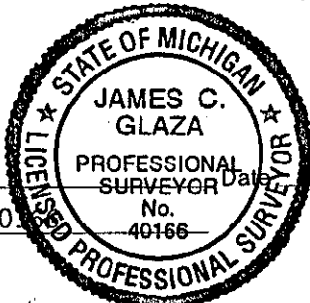

P.A. 345 1983 KENT COUNTY  
PEER APPROVED 10/12/94  
CHAIRMAN Harvey Huber  
Date December 7, 1994