

**SURVEY & REMONUMENTATION**

APR 28 1995

**LAND CORNER RECORDATION CERTIFICATE**  
**COMMISSION Filing Requirement of Act 74, Mich. P.A. 1970**  
**KENT COUNTY REMONUMENTATION**

STATE OF MICHIGAN  
 COUNTY OF KENT  
 RECEIVED FOR RECORD

94 DEC -6 AM 9:06

For corners in


<u>Kent</u> (County)	Located in:	Corner Code #
1. Public Land Survey	T <u>7N</u> R <u>11W</u>	<u>M-8</u>
	T _____ R _____	_____
	T _____ R _____	_____
	T _____ R _____	_____
2. Property Controlling In Section	S _____ T _____ R _____	_____
	S _____ T _____ R _____	_____
3. Miscellaneous Property in Sec.	S _____ T _____ R _____	_____
	S _____ T _____ R _____	_____

*T. J. J. J.*  
 REG. OF DEEDS

7837

Register of Deeds Stamp & File Number

4. Lot No. \_\_\_\_\_, Recorded Plat \_\_\_\_\_  
 5. Private Claims \_\_\_\_\_

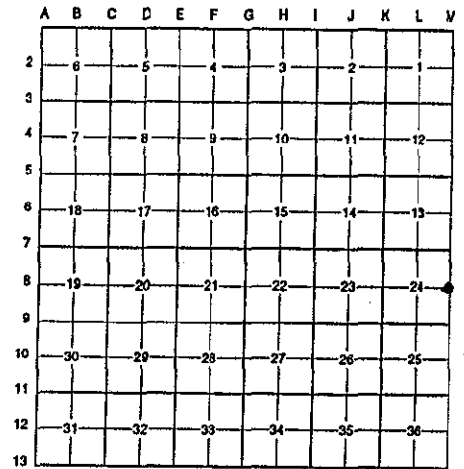

I, Randy Kolehouse, in a field survey on March 22 19 94, do hereby certify that under requirements of P.A. 74 Michigan P.A. of 1970, the corner points mentioned in lines 1 and 2 above were in conformance with regulations and rules therefore as required in the current manual of survey instructions of the United States Department of the Interior, Bureau of Land Management or by a decree of a Court of Law and/or that the corner points mentioned in lines 3, 4 and 5 above were in conformance with the rules of the Michigan Board of Land Surveyors or by a Decree of a Court of Law; established, re-established, monumented, re-monumented, recovered, found as expressed below:

**NOTE: Not more than 4 corners, all in the same town and range, may be recorded on this certificate.**

**A. Description of original monument and accessories and/or subsequent restoration:**

M-8	1831	G.L.O. Notes	L. Lyon	Set Post
	1944	Wit. Map	K.C. Surveyor	2" Iron
	1980	L.C.R.C. #1348	Exxel Engineering	2" Iron
	1981	L.C.R.C. #2149	Jonker	Fnd. 2" Iron/Set K.C. Mon.
	1991	L.C.R.C. #6412	Marschall	K.C. Monument

This corner was originally approved by the Kent County Remonumentation Peer Group and monumented by Robert Jonker on 8/25/81 and was recorded per L.C.R.C. #2149.

**B. Description of corner evidence found and/or method applied in restoring or reestablishing corner:**

M-8 Found standard Kent County Monument in swamp under 8" M/L water per L.C.R.C.'s #2149 and #6412 as set by Rob Jonker in place of a 2" Iron he found which checked L.C.R.C. #1348. This corner is common with A-8 T7N R10W.

L.C.R.C. #2149

L.C.R.C. #6412

Large spike on S side 6" Maple N 64° W 57.16'  
 Large spike on E side 4" Maple S 67° W 48.56'

C/L of 1" pipe for bird house N 45° E 21.50'  
 Large spike on S side 6" Maple N 64° W 57.16'  
 Large spike on E side 5" Maple S 67° W 48.56'

The selected location is accepted by me and is generally accepted by professional surveyors as the best available evidence of the position of the original corner.


**C. Description of monument for corner and accessories established to perpetuate locating the position of the corner:**

M-8 Standard Kent County Monument  
 C/L of 1" pipe for bird house N 73° E 21.50'  
 Large spike on S side 6" Maple N 64° W 57.16'  
 Large spike on E side 5" Maple S 67° W 48.56'  
 Nail & K.C. remon. tag in E face 4" Maple S 11° W 38.85'

P.A. 345 1990 KENT COUNTY

PEER APPROVED 11/17/99

CHAIRMAN *Randy Kolehouse*

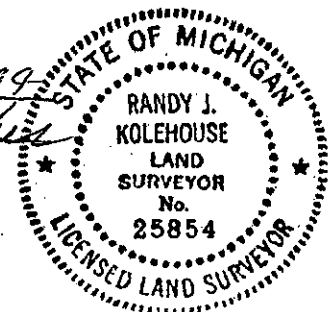

Signed by Randy J. Kolehouse  
 Surveyor's Michigan License No. 25854

Date 12/1/94