

**SURVEY & REMONUMENTATION**

APR 28 1995

COMMISSION

**LAND CORNER RECORDATION CERTIFICATE**  
 Filing Requirement of Act 74, Mich. P.A. 1970  
 KENT COUNTY REMONUMENTATION

STATE OF MICHIGAN  
 COUNTY OF KENT  
 RECEIVED FOR RECORD  
 94 DEC -6 AM 9:06

For corners in

<u>Kent</u> (County)	Located In:	Corner Code #
1. Public Land Survey	T <u>7N</u> R <u>11W</u>	<u>M-9</u>
	T _____ R _____	_____
	T _____ R _____	_____
	T _____ R _____	_____
2. Property Controlling in Section	S _____ T _____ R _____	_____
	S _____ T _____ R _____	_____
3. Miscellaneous Property in Sec.	S _____ T _____ R _____	_____
	S _____ T _____ R _____	_____

*W. J. Gandy*  
 REG. OF DEEDS

7838

Register of Deeds Stamp & File Number

4. Lot No. \_\_\_\_\_, Recorded Plat \_\_\_\_\_  
 5. Private Claims \_\_\_\_\_

I, Randy Kolehouse, in a field survey on July 22 19 94, do hereby certify that under requirements of P.A. 74 Michigan P.A. of 1970, the corner points mentioned in lines 1 and 2 above were in conformance with regulations and rules therefore as required in the current manual of survey instructions of the United States Department of the Interior, Bureau of Land Management or by a decree of a Court of Law and/or that the corner points mentioned in lines 3, 4 and 5 above were in conformance with the rules of the Michigan Board of Land Surveyors or by a Decree of a Court of Law; established, re-established, monumented, re-monumented, recovered, found as expressed below:

	A	B	C	D	E	F	G	H	I	J	K	L	M
2	6	5	4	3	2	1							
3													
4	7	6	5	4	3	2	1						
5													
6	18	17	16	15	14	13	12	11	10	9	8	7	6
7													
8	19	20	21	22	23	24	25	26	27	28	29	30	31
9													
10	30	29	28	27	26	25	24	23	22	21	20	19	18
11													
12	31	32	33	34	35	36	37	38	39	40	41	42	43
13													

NOTE: Not more than 4 corners, all in the same town and range, may be recorded on this certificate.

A. Description of original monument and accessories and/or subsequent restoration:

M-9	1831	G.L.O. Notes	L. Lyon	Set Post
	1940	Wit. Map	K.C. Surveyor	3" Cedar Post in Mud
	1980	L.C.R.C. #1348	Exxel Engineering	1/2" Iron
	1982	L.C.R.C. #3275	C. Hay	Fnd. 1/2" Iron/Set K.C. Mon. & Cedar Post
	1991	L.C.R.C. #6413	Marschall	K.C. Monument

P.A. 345 1990 KENT COUNTY  
 PEER APPROVED 11/17/94  
 CHAIRMAN *Harry Huber*

This corner was originally approved by the Kent County Remonumentation Peer Group and monumented by C.S. Hay on 3/10/82 and was recorded per L.C.R.C. #3275.

B. Description of corner evidence found and/or method applied in restoring or reestablishing corner:

M-9 Found standard Kent County Monument 250' M/L South at Michigan Avenue running E-W in swamp per L.C.R.C.'s #3275 and #6413 as set by C. Hay in place of a "T" iron over a 1/2" iron he found which checked L.C.R.C. #1348. This corner is common with A-9 T7N R10W.

L.C.R.C. #3275

L.C.R.C. #6413


NE side 8" Elm N 80° W 16.68'  
 West side 6" Elm S 10° E 27.98'  
 SE side 8" Maple S 35° W 30.98'  
 NE side 8" Elm S 40° W 26.00'

Nail & tag NE side 8" Elm N 80° W 17.07'  
 Nail & tag W side Twin 6"-4" Maple S 10° E 27.56'  
 Nail & Tag SE side 10" Maple S 35° W 30.77'  
 Nail & tag NE side 8" Elm S 40° E 25.58'

The selected location is accepted by me and is generally accepted by professional surveyors as the best available evidence of the position of the original corner.

C. Description of monument for corner and accessories established to perpetuate locating the position of the corner:

- M-9 Standard Kent County Monument
- Nail & K.C. remon. tag NE side 8" Elm N 80° W 17.00'
  - Nail & K.C. remon. tag W side Twin 6"-4" Maple S 10° E 28.56'
  - Nail & K.C. remon. tag SE side 10" Maple S 35° W 30.90'
  - Nail & K.C. remon. tag NE side 8" Elm S 40° E 25.90'

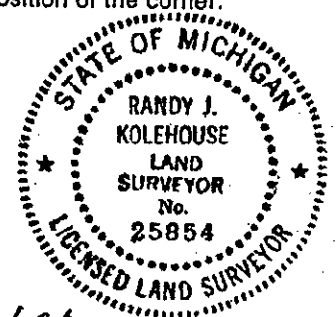

Signed by *Randy J. Kolehouse*

Date 12/1/94

Surveyor's Michigan License No. 25854