

**SURVEY & REMONUMENTATION**

APR 28 1995

**COMMISSION**

**LAND CORNER RECORDATION CERTIFICATE**  
 Filing Requirement of Act 74, Mich. P.A. 1970  
 KENT COUNTY REMONUMENTATION

STATE OF MICHIGAN  
 COUNTY OF KENT  
 RECEIVED FOR RECORD

94 DEC -6 AM 9:06

For corners in

Kent (County)	Located in:	Corner Code #
1. Public Land Survey	T <u>7N</u> R <u>11W</u>	<u>M-13</u>
	T _____ R _____	_____
	T _____ R _____	_____
	T _____ R _____	_____
2. Property Controlling in Section	S _____ T <u>1</u> R _____	_____
	S _____ T _____ R _____	_____
3. Miscellaneous Property in Sec.	S _____ T _____ R _____	_____
	S _____ T _____ R _____	_____

*W. J. Bond*  
 REG. OF DEEDS

**7842**

Register of Deeds Stamp & File Number

4. Lot No. \_\_\_\_\_, Recorded Plat \_\_\_\_\_  
 5. Private Claims \_\_\_\_\_

I, Randy Kolehouse, in a field survey on March 28 19 94, do hereby certify that under requirements of P.A. 74 Michigan P.A. of 1970, the corner points mentioned in lines 1 and 2 above were in conformance with regulations and rules therefore as required in the current manual of survey instructions of the United States Department of the Interior, Bureau of Land Management or by a decree of a Court of Law and/or that the corner points mentioned in lines 3, 4 and 5 above were in conformance with the rules of the Michigan Board of Land Surveyors or by a Decree of a Court of Law; established, re-established, monumented, re-monumented, recovered, found as expressed below:

NOTE: Not more than 4 corners, all in the same town and range, may be recorded on this certificate.

	A	B	C	D	E	F	G	H	I	J	K	L	M
2	6	5	4	3	2	1							
3													
4	7	8	9	10	11	12							
5													
6	18	17	16	15	14	13							
7													
8	19	20	21	22	23	24							
9													
10	30	29	28	27	26	25							
11													
12	31	32	33	34	35	36							
13													

A. Description of original monument and accessories and/or subsequent restoration:

M-13	1831	G.L.O. Notes	L. Lyon	Set Post
	N/A	Wit. Map	K.C. Surveyor	Conc. Mon.
	1947	Survey Records	Williams & Work	Iron and Stone
	1954	L.C.R.C. #3862	Rosema	Fnd. Iron/Set K.C. Mon.
	1991	L.C.R.C. #6419	Marschall	K.C. Mon.

P.A. 345 1990 KENT COUNTY  
 PEER APPROVED 11/3/94  
 CHAIRMAN Harry Huber

This corner was originally approved by the Kent County Remonumentation Peer Group and monumented by Maurice J. Rosema on 7/11/84 and was recorded per L.C.R.C. #3862.

B. Description of corner evidence found and/or method applied in restoring or reestablishing corner:

M-13 Found standard Kent County Monument in the C/L of Patterson Avenue running N-S on C/L Hall Street running West per L.C.R.C.'s #3862 and #6419 as set by M. Rosema in place of a 1/2" iron he found which checked Eastmont Plat and Eastmont Gardens Plat.

L.C.R.C. #3862

L.C.R.C. #6419


Nail & tag N side 10" Apple N 43° W 47.26'  
 Top C/L nut hydrant N 50° E 67.25'  
 On C/L x Patterson and Hall Street

Nail & tag N side 10" Apple N 43° W 47.26'  
 Top C/L nut hydrant N 50° E 67.25'  
 On C/L x Patterson and Hall Street

The selected location is accepted by me and is generally accepted by professional surveyors as the best available evidence of the position of the original corner.

C. Description of monument for corner and accessories established to perpetuate locating the position of the corner:

- 13 Standard Kent County Monument
  - Nail & K.C. remon. tag N side 10" Apple N 43° W 47.26'
  - Top C/L nut hydrant N 50° E 67.25'
  - On C/L x Patterson and Hall Street
  - Nail & K.C. remon. tag SW side p. pole S 34° E 83.02'
  - Nail & K.C. remon. tag NW side Twin 10" Birch S 45° W 52.77'
  - Nail & K.C. remon. tag SE side 12" Box Elder N 26° E 78.13'

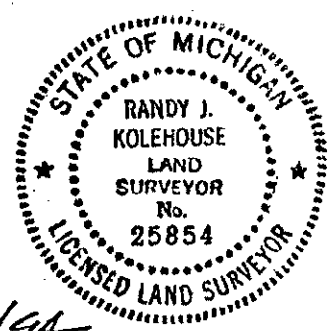

Surveyed by Randy J. Kolehouse  
 Surveyor's Michigan License No. 25854

Date 12/1/94