

**SURVEY & REMONUMENTATION**

APR 28 1995

KENT COUNTY REMONUMENTATION

**COMMISSION LAND CORNER RECORDATION CERTIFICATE**  
 Filing Requirement of Act 74, Mich. P.A. 1970

STATE OF MICHIGAN  
 COUNTY OF KENT  
 RECEIVED FOR RECORD

94 NOV 28 AM 11:42

For corners in  
KENT COUNTY  
 (County)

Located in: Corner Code A-2

- 1. Public Land Survey T 7N R 12W A-2  
 T \_\_\_\_\_ R \_\_\_\_\_  
 T \_\_\_\_\_ R \_\_\_\_\_  
 T \_\_\_\_\_ R \_\_\_\_\_
- 2. Property Controlling S \_\_\_\_\_ T \_\_\_\_\_ R \_\_\_\_\_  
 in Section S \_\_\_\_\_ T \_\_\_\_\_ R \_\_\_\_\_
- 3. Miscellaneous S \_\_\_\_\_ T \_\_\_\_\_ R \_\_\_\_\_  
 Property in Sec. S \_\_\_\_\_ T \_\_\_\_\_ R \_\_\_\_\_
- 4. Lot No. \_\_\_\_\_, Recorded Plat \_\_\_\_\_
- 5. Private Claims \_\_\_\_\_

*Leif Bond*  
 REG. OF DEEDS

7269

Register of Deeds Stamp & File Number

A	B	C	D	E	F	G	H	I	J	K	L	M
2	6	5	4	3	2							
3												
4	7	8	9	10	11	12						
5												
6	18	17	16	15	14	13						
7												
8	19	20	21	22	23	24						
9												
10	30	29	28	27	26	25						
11												
12	31	32	33	34	35	36						
13												

I, William R. Byl, in a field survey on July 1, 19 94, do hereby certify that under requirements of P.A. 74, Michigan P.A. of 1970, the corner points mentioned in lines 1 and 2 above were in conformance with regulations and rules therefore as required in the current manual of survey instructions of the United States Department of the Interior, Bureau of Land Management or by a decree of a Court of Law and/or that the corner points mentioned in lines 3, 4 and 5 above were in conformance with the rules of the Michigan Board of Land Surveyors or by a Decree of a Court of Law; established, re-established, monumented, re-monumented, recovered, found as expressed below:

**NOTE: Not more than 4 corners, all in the same town and range, may be recorded on this certificate.**

A. Description of original monument and accessories and/or subsequent restoration:

A-2	1837	GLO	Brookfield	Set Post (common M-2, T7N, R13W)
	1960	Kent Co. Wit	MDSH	1 1/2" x 36" Iron Bar
	1975	LCRC #806	Ruzzala	3/8" x 36" Flat Iron
	1982	LCRC #3167	Jonker	Set Kent County Monument
	1990	LCRC #5496	Starr	Kent County Monument

The position of this corner was previously approved by the Kent County Remonumentation Peer Group, monumented by Douglas W. Bonnema on 12/3/82 and was recorded per LCRC #3197.

B. Description of corner evidence found and/or method applied in restoring or reestablishing corner:

A-2 Found standard Kent Co. Mon. (Harrison) per witnesses from above LCRC as set by Robert J. Jonker in place of the 3/8" x 1 1/2" x 36" Flat Iron he found. Said Flat Iron checks with Kent Co. Wit. & LCRC #806.

LCRC #3167

Remon. tag E. sd. 18" Tw. W. Cherry	S10°E	35.28'
Remon. tag N. sd. 16" W. Cherry	N85°E	28.41'
Remon. tag SE sd. 10" Beech	N20°E	22.57'
Remon. tag NE sd. 36" Beech	N55°W	65.72'
Remon. tag NW sd. 6" Maple	S50°W	23.84'

LCRC #5496

Same witnesses as  
 LCRC #3167

At intersection fences to W,S,E

The selected location is accepted by me and is generally accepted by professional surveyors as the best available evidence of the position of the original corner.

C. Description of monument for corner and accessories established to perpetuate locating the position of the corner:


A-2 Standard Kent County Monument

New Nail & KC Remon. tag E. sd. 22" Tw. W. Cherry	S10°E	35.30'
New Nail & KC Remon. tag N. sd. 20" W. Cherry	N85°E	28.48'
Nail & KC Remon. tag SE sd. 14" Beech	N20°E	22.57'
Nail & KC Remon. tag NE sd. 40" Beech	N55°W	65.66'
Nail & KC Remon. tag NW sd. 9" Maple	S50°W	23.90'

P.A. 345 1990 KENT COUNTY

PEER APPROVED 11/17/94

CHAIRMAN *Henry Fisher*

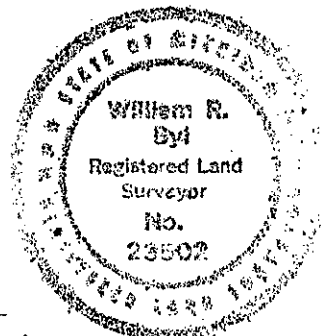

Signed by *W. R. Byl* Date 11-17-94  
 Surveyor's Michigan License No. 23502