

# SURVEY & REMONUMENTATION

KENT COUNTY REMONUMENTATION

APR 28 1995

## LAND CORNER RECORDATION CERTIFICATE Filing Requirement of Act 74, Mich. P.A. 1970

### COMMISSION

STATE OF MICHIGAN  
COUNTY OF KENT  
RECEIVED FOR RECORD  
94 NOV 28 AM 11:42

For corners in  
KENT COUNTY

(County)	Located In:	Corner Code #
1. Public Land Survey	T <u>7N</u> R <u>12W</u>	<u>A-4</u>
	T _____ R _____	_____
	T _____ R _____	_____
	T _____ R _____	_____
2. Property Controlling In Section	S _____ T _____ R _____	_____
	S _____ T _____ R _____	_____
3. Miscellaneous Property in Sec.	S _____ T _____ R _____	_____
	S _____ T _____ R _____	_____
4. Lot No. _____, Recorded Plat _____		
5. Private Claims _____		

*Lucy J. Bond*  
REG. OF DEEDS

7271

Register of Deeds Stamp & File Number

	A	B	C	D	E	F	G	H	I	J	K	L	M
2	6	5	4	3	2	1							
3													
4	7	8	9	10	11	12							
5													
6	18	17	16	15	14	13							
7													
8	19	20	21	22	23	24							
9													
10	30	29	28	27	26	25							
11													
12	31	32	33	34	35	36							
13													

I, William R. Byl, in a field survey on July 5, 19 94, do hereby certify that under requirements of P.A. 74, Michigan P.A. of 1970, the corner points mentioned in lines 1 and 2 above were in conformance with regulations and rules therefore as required in the current manual of survey instructions of the United States Department of the Interior, Bureau of Land Management or by a decree of a Court of Law and/or that the corner points mentioned in lines 3, 4 and 5 above were in conformance with the rules of the Michigan Board of Land Surveyors or by a Decree of a Court of Law; established, re-established, monumented, re-monumented, recovered, found as expressed below:

**NOTE: Not more than 4 corners, all in the same town and range, may be recorded on this certificate.**

**A. Description of original monument and accessories and/or subsequent restoration:**

A-4	1836	GLO	Brookfield	Set Post (common with M-4, T7N, R13W)
	1965	Kent Co. Wit.		Iron & Stone
	1975	LCRC #828	Ruzzala	1" Iron
	1980	Wm. R. Byl, Inc.	Byl	Found bent iron, set RR spike over Stone
	1980	LCRC #1448	Merdzinski	Set Kent County Monument
	1990	LCRC #5498	Starr	Kent County Monument

The position of this corner was previously approved by the Kent County Remonumentation Peer Group, monumented by John A. Merdzinski on 10/24/80 and was recorded per LCRC #1448.

**B. Description of corner evidence found and/or method applied in restoring or reestablishing corner:**

A-4 Found "Ottawa County Monument" as set after road construction (approx. 1991) which matches the witnesses from above LCRC as used by John A. Merdzinski when he set a Kent Co. Mon. in place of the RR spike & stone that he found. Said RR spike over stone checks with Kent Co. Wit. & LCRC #828.


LCRC #1448				LCRC #5498			
Nail & KC tag MBT Pole	West	24.51'		Nail & KC tag MBT Pole	West	24.51'	
Nail & KC tag 18" Maple	N10°W	173.42'		Nail & KC tag 18" Maple	N10°W	173.42'	
Nail & KC tag 6" Elm	S65°E	58.73'		"+" cut E. end conc. culv.	S10°E	136.11'	
Nail & KC tag 10" Elm	S30°E	112.11'		"+" cut W. end conc. culv.	S10°W	134.66'	
"+" E. end conc. culv.	S10°E	136.11'		Nail & KC tag 6" Elm	N80°E	45.58'	
"+" W. end conc. culv.	S10°W	134.66'		On C/L N-S Grav. Rd.; On E-W Tele. Line			

The selected location is accepted by me and is generally accepted by professional surveyors as the best available evidence of the position of the original corner.

**C. Description of monument for corner and accessories established to perpetuate locating the position of the corner:**

A-4 Ottawa County Monument			
New Nail & KC tag E. side 24" Maple	N10°W	173.38'	
Chiseled "+" cut W. end conc. culv.	S75°W	34.18'	
Chiseled "+" cut E. end conc. culv.	S75°E	31.68'	
Top C/L MBT Box	S90°W	25.00'	
New Nail & KC Remon. tag N. side 12" Oak	N80°E	45.51'	
On C/L N-S Asphalt Rd.			

P.A. 345 1990 KENT COUNTY  
PEER APPROVED 11/17/94  
CHAIRMAN Harry Fisher

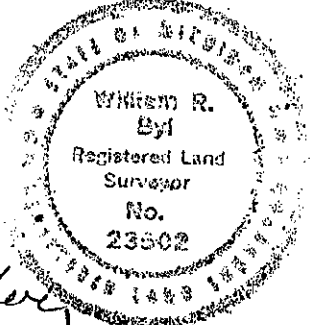

Signed by William R. Byl Date 11-17-94  
Surveyor's Michigan License No. 23502