

SURVEY & REMONUMENTATION

KENT COUNTY REMONUMENTATION

STATE OF MICHIGAN
COUNTY OF KENT
RECEIVED FOR RECORD

APR 28 1995

LAND CORNER RECORDATION CERTIFICATE

Filing Requirement of Act 74, Mich. P.A. 1970

94 NOV 28 AM 11:53

For corners in **COMMISSION**
KENT COUNTY

Located In:	Corner Code #
1. Public Land Survey T <u>7N</u> R <u>12W</u>	<u>A-8</u>
T _____ R _____	_____
T _____ R _____	_____
T _____ R _____	_____
2. Property Controlling in Section S _____ T _____ R _____	_____
S _____ T _____ R _____	_____
3. Miscellaneous Property in Sec. S _____ T _____ R _____	_____
S _____ T _____ R _____	_____
4. Lot No. _____, Recorded Plat _____	_____
5. Private Claims _____	_____

W. R. Byl
REG. OF DEEDS

7275

Register of Deeds Stamp & File Number

I, William R. Byl, in a field survey on Sept. 1, 19 94, do hereby certify that under requirements of P.A. 74, Michigan P.A. of 1970, the corner points mentioned in lines 1 and 2 above were in conformance with regulations and rules therefore as required in the current manual of survey instructions of the United States Department of the Interior, Bureau of Land Management or by a decree of a Court of Law and/or that the corner points mentioned in lines 3, 4 and 5 above were in conformance with the rules of the Michigan Board of Land Surveyors or by a Decree of a Court of Law; established, re-established, monumented, re-monumented, recovered, found as expressed below:

NOTE: Not more than 4 corners, all in the same town and range, may be recorded on this certificate.

	A	B	C	D	E	F	G	H	I	J	K	L	M
2	6	5	4	3	2	1							
3													
4	7	8	9	10	11	12							
5													
6	18	17	16	15	14	13							
7													
8	19	20	21	22	23	24							
9													
10	30	29	28	27	26	25							
11													
12	31	32	33	34	35	36							
13													

A. Description of original monument and accessories and/or subsequent restoration:

A-8	1836	GLO	Brookfield	Set Post (common with M-8, T7N, R13W)
		Kent Co. Wit.		Monument
	1981	LCRC #2030	Hackbardt	Set Kent County Monument
	1990	LCRC #5502	Starr	Kent County Monument

The position of this corner was previously approved by the Kent County Remonumentation Peer Group, monumented by Glen S. Hackbardt on 6/9/81 and was recorded per LCRC #2030.

B. Description of corner evidence found and/or method applied in restoring or reestablishing corner:

A-8 Found standard Kent Co. Mon. (Harrison) per witnesses from above LCRC as set by Glen S. Hackbardt in place of the Conc. Monument with a 3/4 Iron he found. Said Conc. Monument and 3/4" Iron checks with Kent Co. Wit. and survey information by others.

LCRC #2030	LCRC #5502
KC Nail & tag clump 5" Maple	S50°E 37.40'
KC Nail & tag 18" Hickory	S07°E 40.74'
KC Nail & tag 8" Oak	S80°W 83.86'
KC Nail & tag 6" Oak	S80°E 37.86'
	same witnesses as LCRC #2030

The selected location is accepted by me and is generally accepted by professional surveyors as the best available evidence of the position of the original corner.


C. Description of monument for corner and accessories established to perpetuate locating the position of the corner:

A-8 Standard Kent County Monument	
New Nail & KC Remon. tag SW side clump 8" Maple	S50°E 37.50'
New Nail & KC Remon. tag W. side 20" Hickory	S07°E 40.74'
New Nail & KC Remon. tag S. side 10" Oak	S80°W 83.22'
New Nail & KC Remon. tag N. side 8" Oak	S80°E 37.86'

P.A. 345 1990 KENT COUNTY

PEER APPROVED 11/17/94

CHAIRMAN Harry Huber

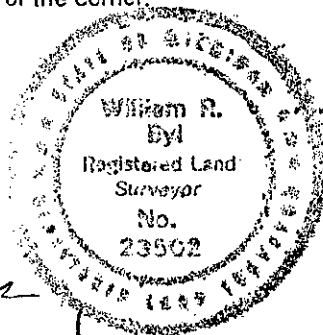

Signed by W. R. Byl Date 11-17-94
Surveyor's Michigan License No. 23502