

**SURVEY & REMONUMENTATION**

APR 28 1995

KENT COUNTY REMONUMENTATION

**COMMISSION LAND CORNER RECORDATION CERTIFICATE**  
 Filing Requirement of Act 74, Mich. P.A. 1970

STATE OF MICHIGAN,  
 COUNTY OF KENT  
 RECEIVED FOR RECORD

94 DEC 27 AM 9:04

For corners in  
KENT COUNTY

(County)	Located In:	Corner Code #
1. Public Land Survey	T <u>7N</u> R <u>12W</u>	A-11
	T _____ R _____	_____
	T _____ R _____	_____
	T _____ R _____	_____
2. Property Controlling in Section	S _____ T _____ R _____	_____
	S _____ T _____ R _____	_____
3. Miscellaneous Property in Sec.	S _____ T _____ R _____	_____
	S _____ T _____ R _____	_____

*Levi J. Bond*  
 REG. OF DEEDS


7890

Register of Deeds Stamp & File Number

4. Lot No. \_\_\_\_\_, Recorded Plat \_\_\_\_\_  
 5. Private Claims \_\_\_\_\_

I, William R. Byl, in a field survey on July 21, 19 94

do hereby certify that under requirements of P.A. 74, Michigan P.A. of 1970, the corner points mentioned in lines 1 and 2 above were in conformance with regulations and rules therefore as required in the current manual of survey instructions of the United States Department of the Interior, Bureau of Land Management or by a decree of a Court of Law and/or that the corner points mentioned in lines 3, 4 and 5 above were in conformance with the rules of the Michigan Board of Land Surveyors or by a Decree of a Court of Law; established, re-established, monumented, re-monumented, recovered, found as expressed below:

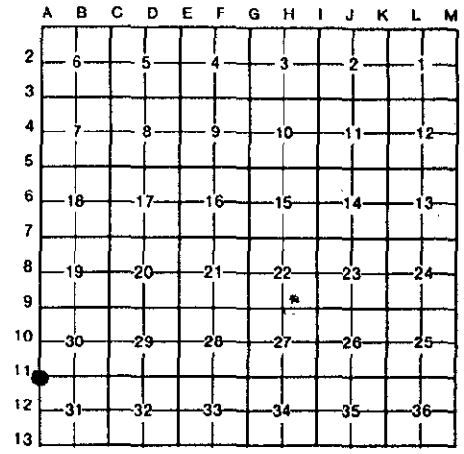

**NOTE: Not more than 4 corners, all in the same town and range, may be recorded on this certificate.**

A. Description of original monument and accessories and/or subsequent restoration:

Corner Code	Year	Monument	Material	Restoration
A-11	1837	GLO	Whitcomb	Set Post
	1960	Kent Co. Wit.		Leaded Stone
	1973	LCRC #616	Varba	Leaded Stone
	1975	LCRC #798	McCloskey	Leaded Stone
	1980	LCRC #1473	Merdzinski	Set Kent County Monument
	1990	LCRC #5505	Starr	Kent County Monument

P.A. 345 1990 KENT COUNTY  
 PEER APPROVED 12/22/94  
 CHAIRMAN *Harry Stupiec*

The position of this corner was previously approved by the Kent County Remonumentation Peer Group, monumented by John A. Merdzinski on 10/31/80 and was recorded per LCRC #1473

B. Description of corner evidence found and/or method applied in restoring or reestablishing corner:

A-11 Found standard Kent Co. Mon. (Harrison) per witnesses from above LCRC as set by John A. Merdzinski over top of the Leaded Stone he found. Said Leaded Stone checks with Kent Co. Wit. and LCRC's #616 & #798.


LCRC #1473			LCRC #5505		
Nail & tag 30" Maple	S15°E	90.87'	Nail & KC tag W. side 30" Maple	S15°E	90.87'
Nail & tag 10" Maple	S45°E	54.45'	Nail & KC tag E. side 14" Maple	North	34.15'
Nail & tag 14" Maple	N	34.15'	Nail & KC tag N. side 14" Maple	S60°E	67.78'
Nail & tag 14" Maple	S60°E	67.78'	Nail & KC tag S. side 10" Maple	N45°W	33.08'
Nail & tag 10" Maple	N45°W	32.98'	Nail & KC tag SE side 6" Tri-Maple	N45°E	18.01'
Nail & tag 6" Tri-Maple	N45°E	17.95'	Face 2" dia. steel post	N35°W	0.40'
Face 2" dia. steel post	N35°W	0.40'			

The selected location is accepted by me and is generally accepted by professional surveyors as the best available evidence of the position of the original corner.

C. Description of monument for corner and accessories established to perpetuate locating the position of the corner:

A-11 Standard Kent County Monument

Nail & KC Remon. tag E. side	16" Maple	N00°E	34.22'
Nail & KC Remon. tag N. side	16" Maple	S60°E	67.78'
New Nail & KC Remon. tag S. side	12" Maple	N45°W	33.13'
Nail & KC Remon. tag SE side	6" Tri-Maple	N45°E	18.07'
Set Nail & KC Remon. tag NE side	10" Maple	S35°W	4.03'
Face 2" dia. steel post		N35°W	0.40'

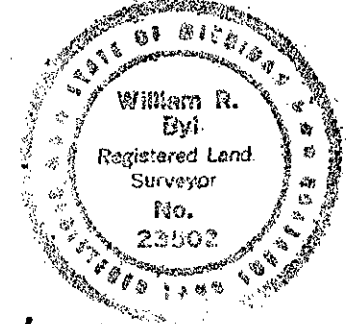

Signed by *William R. Byl*  
 Surveyor's Michigan License No. 23502

Date 12/07/94