

SURVEY & REMONUMENTATION

KENT COUNTY REMONUMENTATION

APR 28 1995

LAND CORNER RECORDATION CERTIFICATE

Filing Requirement of Act 74, Mich. P.A. 1970

STATE OF MICHIGAN
COUNTY OF KENT
RECEIVED FOR RECORD

94 NOV 28 AM 11:43

For corners in **COMMISSION**
KENT COUNTY

(County)

Located In:

Corner Code #

1. Public Land Survey	T	<u>7N</u>	R	<u>12W</u>	<u>A-13</u>
	T	_____	R	_____	_____
	T	_____	R	_____	_____
	T	_____	R	_____	_____
2. Property Controlling in Section	S	_____	T	_____	R
	S	_____	T	_____	R
3. Miscellaneous Property in Sec.	S	_____	T	_____	R
	S	_____	T	_____	R

Lucy Bond
REG. OF DEEDS

7279

Register of Deeds Stamp & File Number

4. Lot No. _____, Recorded Plat _____
5. Private Claims _____

	A	B	C	D	E	F	G	H	I	J	K	L	M
2	6	5	4	3	2	1							
3													
4	7	8	9	10	11	12							
5													
6	16	17	16	15	14	13							
7													
8	19	20	21	22	23	24							
9													
10	30	29	28	27	26	25							
11													
12	31	32	33	34	35	36							
13													

I, William R. Bvl, in a field survey on July 1, 1994, do hereby certify that under requirements of P.A. 74, Michigan P.A. of 1970, the corner points mentioned in lines 1 and 2 above were in conformance with regulations and rules therefore as required in the current manual of survey instructions of the United States Department of the Interior, Bureau of Land Management or by a decree of a Court of Law and/or that the corner points mentioned in lines 3, 4 and 5 above were in conformance with the rules of the Michigan Board of Land Surveyors or by a Decree of a Court of Law; established, re-established, monumented, re-monumented, recovered, found as expressed below:

NOTE: Not more than 4 corners, all in the same town and range, may be recorded on this certificate.

A. Description of original monument and accessories and/or subsequent restoration:

A-13	1836	GLO	Brookfield	Set Post (Township Corner)
	1953	Kent Co. Wit. (T6N, R12W)		Stone
	1972	LCRC #328	Spicer	3/4" Iron over Stone
	1977	LCRC #1046 (T6N, R12W)	Mredzinski	1" Solid Iron
	1980	LCRC #1446 (T6N, R12W)	Merdzinski	Set Kent County Monument
	1990	LCRC #5507	Starr	Kent County Monument

The position of this corner was previously approved by the Kent County Remonumentation Peer Group, monumented by John A. Merdzinski on 10/24/80 and was recorded per LCRC #1446

B. Description of corner evidence found and/or method applied in restoring or reestablishing corner:


A-13 Found standard Kent Co. Mon. (Harrison) per witnesses from above LCRC as set by John A. Merdzinski in place of the 1" Solid Iron and Stone with "X" cut that he found. Said 1" Iron & Stone checks with Kent Co. Wit. & LCRC's #328 & #1046.

LCRC #1446				LCRC #5507			
Nail & KC tag 16" Hackberry	N30°E	41.02'		Nail & tag 16" Hackberry	N30°E	40.92'	
Nail & KC tag 22" Hickory	S80°E	56.55'		Nail & tag 22" Hickory	S80°E	56.55'	
Nail & KC tag 18" Hackberry	S20°E	72.33'		Nail & tag 18" Hackberry	S20°E	72.00'	
Nail & KC tag P. Pole	N65°W	108.08'		Nail & tag P. Pole	N65°W	108.08'	
Nail & KC tag Tele. Pole	N35°W	64.54'		Nail & tag T. Pole	N35°W	67.54'	
Nail & KC tag P. Pole	N75°E	195.97'		Nail & tag Lt. Pole	S75°W	31.19'	

On S. edge Grav. Rd. E.; Near E. edge Grav. Rd. N-S
The selected location is accepted by me and is generally accepted by professional surveyors as the best available evidence of the position of the original corner.

C. Description of monument for corner and accessories established to perpetuate locating the position of the corner:

A-13 Standard Kent County Monument			
New Nail & KC Remon. tag E. side 18" Hackberry	N30°E	40.93'	
Nail & KC Remon. tag N. side 22" Hickory stump	S80°E	56.35'	
Nail & KC Remon. tag W. side 20" Hackberry	S20°E	72.00'	
Nail & KC Remon. tag N. side P. Pole	N65°W	108.20'	
Nail & KC Remon. tag E. side Tele. Pole	N35°W	64.50'	
Nail & KC Remon. tag N. side Lt. Pole	S75°W	31.24'	
On S. edge Tar & Stone Rd. E.; Near E. edge Grav. Rd. N-S			

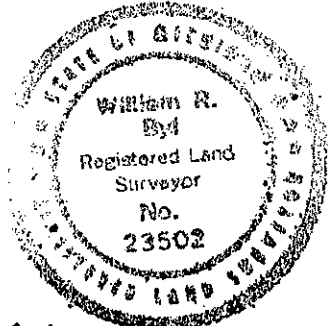

Signed by William R. Bvl Date 11-17-94
CHAIRMAN Harold Stuber

Surveyor's Michigan License No. 23502