

SURVEY & REMONUMENTATION KENT COUNTY REMONUMENTATION

APR 28 1995

LAND CORNER RECORDATION CERTIFICATE

Filing Requirement of Act 74, Mich. P.A. 1970

STATE OF MICHIGAN
COUNTY OF KENT
RECEIVED FOR RECORD

94 NOV 28 AM 11:45

For corners in **KENT COUNTY COMMISSION**

(County)	Located In:	Corner Code #
1. Public Land Survey	T <u>7N</u> R <u>12W</u>	B-1
	T _____ R _____	_____
	T _____ R _____	_____
	T _____ R _____	_____
2. Property Controlling in Section	S _____ T _____ R _____	_____
	S _____ T _____ R _____	_____
3. Miscellaneous Property in Sec.	S _____ T _____ R _____	_____
	S _____ T _____ R _____	_____

W. R. Byl
REG. OF DEEDS

7280

Register of Deeds Stamp & File Number

4. Lot No. _____, Recorded Plat _____
5. Private Claims _____

	A	B	C	D	E	F	G	H	I	J	K	L	M
2	8	5	4	3	2	1							
3													
4	7	6	9	10	11	12							
5													
6	18	17	16	15	14	13							
7													
8	19	20	21	22	23	24							
9													
10	30	29	28	27	26	25							
11													
12	31	32	33	34	35	36							
13													

I, William R. Byl, in a field survey on July 1, 19 94, do hereby certify that under requirements of P.A. 74, Michigan P.A. of 1970, the corner points mentioned in lines 1 and 2 above were in conformance with regulations and rules therefore as required in the current manual of survey instructions of the United States Department of the Interior, Bureau of Land Management or by a decree of a Court of Law and/or that the corner points mentioned in lines 3, 4 and 5 above were in conformance with the rules of the Michigan Board of Land Surveyors or by a Decree of a Court of Law; established, re-established, monumented, re-monumented, recovered, found as expressed below:

NOTE: Not more than 4 corners, all in the same town and range, may be recorded on this certificate.

A. Description of original monument and accessories and/or subsequent restoration:

B-1	1837 GLO	Not set
	1946-66 Williams & Works	Iron 95.9' W. of B-13, T8N, R12W
	1963 Kent Co. Wit.	3/4" Iron
	1975 LCRC #805 Ruzsalla	3/4" Iron
	1984 LCRC #3859 Kolehouse	Set Kent County Monument

The position of this corner was previously approved by the Kent County Remonumentation Peer Group, monumented by Randy J. Kolehouse on 5/21/84 and was recorded per LCRC #3859

B. Description of corner evidence found and/or method applied in restoring or reestablishing corner:

B-1 Found standard Kent Co. Mon. (Harrison) per witnesses from above LCRC as set by Randy J. Kolehouse in place of the 1" Iron he found. Said 1" Iron checks with Williams & Works information, Kent Co. Wit. and LCRC #805.

LCRC #3859


Nail & KC Remon. tag W. side 24" Hickory	South	22.07'
Nail & KC Remon. tag SW side P. Pole	N45°W	39.05'
Nail & KC Remon. tag NE side 21" Walnut	S35°E	42.04'
Chiseled "X" in top conc. hdwl.	N70°E	68.5'
KC Monument at S 1/4 cor. Sec. 31, T8N, R12W	East	95.9'

P.A. 345 1990 KENT COUNTY
PEER APPROVED 11/17/94
CHAIRMAN [Signature]

The selected location is accepted by me and is generally accepted by professional surveyors as the best available evidence of the position of the corner.

C. Description of monument for corner and accessories established to perpetuate locating the position of the corner:

B-1 Standard Kent County Monument		
New Nail & KC Remon. tag W. side 27" Hickory	S00°E	22.06'
Nail & KC Remon. tag SW side P. Pole	N45°W	39.10'
Nail & KC Remon. tag NE side 24" Walnut	S35°E	42.04'
Fd. Chiseled "X" in top conc. hdwl.	N70°E	66.90'
KC Mon. at S 1/4 cor. Sec. 31, T8N, R12W	East	95.9'

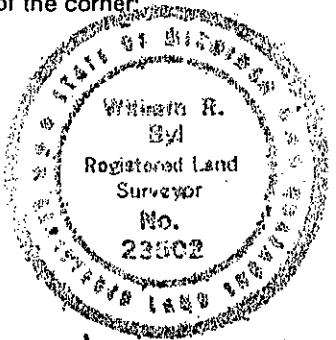

Signed by W. R. Byl
Surveyor's Michigan License No. 23502

Date 11-17-94