

\$7.00
\$2.00

**SURVEY &
MONUMENTATION**

KENT COUNTY REMONUMENTATION

JAN 24 1996

LAND CORNER RECORDATION CERTIFICATE

Filing Requirement of Act 74, Mich. P.A. 1970

COMMISSION

For corners in
KENT COUNTY
(County)

Located In:

Corner Code #

1. Public Land Survey	T	<u>7N</u>	R	<u>12W</u>	<u>B-2</u>
	T	_____	R	_____	_____
	T	_____	R	_____	_____
	T	_____	R	_____	_____
2. Property Controlling in Section	S	_____	T	_____	_____
	S	_____	T	_____	_____
3. Miscellaneous Property in Section	S	_____	T	_____	_____
	S	_____	T	_____	_____

4. Lot No. _____, Recorded Plat _____
 5. Private Claims _____

STATE OF MICHIGAN
 COUNTY OF KENT
 RECEIVED FOR RECORD
 95 DEC 26 PM 12:42
 REG. OF DEEDS
 8838
 Register of Deeds Stamp & File Number

A	B	C	D	E	F	G	H	I	J	K	L
2	6	5	4	3	2	1					
3											
4	7	8	9	10	11	12					
5											
6	18	17	16	15	14	13					
7											
8	19	20	21	22	23	24					
9											
10	30	29	28	27	26	25					
11											
12	31	32	33	34	35	36					
13											

I, Kirk Breitels, in a field survey on Nov. 15, 1994, do hereby certify that under requirements of P.A. 74, Michigan P.A. of 1970, the corner points mentioned in lines 1 and 2 above were in conformance with regulations and rules therefore as required in the current manual of survey instructions of the United States Department of the Interior, Bureau of Land Management or by a decree of a Court of Law and/or that the corner points mentioned in lines 3, 4 and 5 above were in conformance with the rules of the Michigan Board of Professional Surveyors or by a Decree of a Court of Law; established, re-established, monumented, re-monumented, recovered, found as expressed below:

NOTE: Not more than 4 corners, all in the same town and range, may be recorded on this certificate.

A. Description of original monument and accessories and/or subsequent restoration:

- B-2 1837 GLO Not Set
- 1946-69 Williams & Works Pointed Stone
- 10" Maple NE 9.60' 24" Cherry ENE 15.7'
- 15" Elm S. 19.20' 6" Elm W. 4.40'
- 1960 Kent Co. Wit. Pointed Stone
- 15" Maple NNE 10.05' 12" Tri. Cherry ENE 16.33'
- 18" Elm S. 19.20' 6" Elm WNW 4.53'
- 1975 LCRC #801 Ruszala Pointed Stone
- 12" Maple Az 41° 10.09' 24" Elm Az 300°17.77' 8" Maple Az 170° 16.86'

B. Description of corner evidence found and/or method applied in restoring or reestablishing corner:


B-2 Found Pointed Stone that fit remaining witnesses of those above. Said Pointed Stone is 6.4' E. & 0.6' S. from true intersection of 1/4 lines and fits measurements by others.

The Pointed Stone is accepted by me and is generally accepted by professional surveyors as the best available evidence of the position of the corner.

P.A. 345 1990 KENT COUNTY
 PEER APPROVED 11/17/94
 CHAIRMAN Henry Hubert

C. Description of monument for corner and accessories established to perpetuate locating the position of the corner:

- B-2 Set Standard Kent County Monument in place of the Pointed Stone
- Set Nail & KC Remon. tag E. side 22" Maple N45°E 10.10'
- Set Nail & KC Remon. tag E. side 14" Maple S20°E 16.81'
- Set Nail & KC Remon. tag W. side 15" Elm N10°E 17.17'
- Set Nail & KC Remon. tag N. side 14" Maple N80°W 52.34'
- Set Nail & KC Remon. tag SW side 14" Oak S40°E 41.41'
- Fence Corner is SE 1'

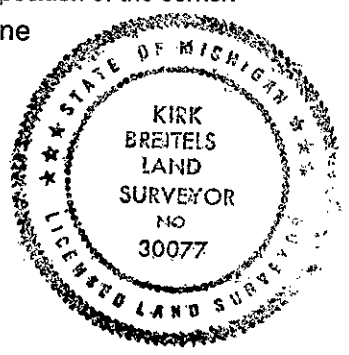

Signed by Kirk Breitels

Date 12/14/95

Surveyor's Michigan License No. 30077