

\$7.00
\$2.00

JAN 24 1996

KENT COUNTY REMONUMENTATION

COMMISSION LAND CORNER RECORDATION CERTIFICATE
Filing Requirement of Act 74, Mich. P.A. 1970

For corners in
KENT COUNTY
(County)

Located In:

Corner Code #

1. Public Land Survey	T	<u>7N</u>	R	<u>12W</u>	<u>B-6</u>
	T	_____	R	_____	_____
	T	_____	R	_____	_____
	T	_____	R	_____	_____
2. Property Controlling in Section	S	_____	T	_____	_____
	S	_____	T	_____	_____
3. Miscellaneous Property in Section	S	_____	T	_____	_____
	S	_____	T	_____	_____

STATE OF MICHIGAN
COUNTY OF KENT
RECEIVED FOR RECORD

95 DEC 26 PM 12:42

REG. OF DEEDS
Luigi Bondi
8852

Register of Deeds Stamp & File Number

4. Lot No. _____, Recorded Plat _____
5. Private Claims _____

A	B	C	D	E	F	G	H	I	J	K	L	M
2	6	5	4	3	2	1						
3												
4	7	8	9	10	11	12						
5												
6	18	17	16	15	14	13						
7												
8	19	20	21	22	23	24						
9												
10	30	29	28	27	26	25						
11												
12	31	32	33	34	35	36						
13												

I, Kirk Breitels, in a field survey on Nov. 15, 19 94
do hereby certify that under requirements of P.A. 74, Michigan P.A. of 1970, the corner points mentioned in lines 1 and 2 above were in conformance with regulations and rules therefore as required in the current manual of survey instructions of the United States Department of the Interior, Bureau of Land Management or by a decree of a Court of Law and/or that the corner points mentioned in lines 3, 4 and 5 above were in conformance with the rules of the Michigan Board of Professional Surveyors or by a Decree of a Court of Law; established, re-established, monumented, re-monumented, recovered, found as expressed below:

NOTE: Not more than 4 corners, all in the same town and range, may be recorded on this certificate.

A. Description of original monument and accessories and/or subsequent restoration:

B-6	1837	GLO		Not Set
	1915	Williams & Works		Stake
	1935	Kent Co. Wit.		Mon. Box
		20" Oak ENE 79.6'	15" Oak NW 74.05'	
		28" Oak E. 75.7'	20" Oak NW 40.2'	
	1940-69	Williams & Works		Mon. Box
	1972	LCRC #112	Bonnema	Iron in mon. box
		28" Oak ENE 76.38'	24" Oak WNW 40.92'	10" Maple SE 90.78'
		Exxel Eng.		Used per LCRC #112

B. Description of corner evidence found and/or method applied in restoring or reestablishing corner:

B-6 Found Iron (large spike) in mon. box that fits remaining witnesses of those above. Said Iron in mon. box is 1.1' S. & 0.2' E. from true intersection of 1/4 lines and fits measurements of others.


The Iron in mon. box is accepted by me and is generally accepted by professional surveyors as the best available evidence of the position of the corner.

P.A. 345 1990 KENT COUNTY
PEER APPROVED 11/27/94
CHAIRMAN *Harry Hubert*

C. Description of monument for corner and accessories established to perpetuate locating the position of the corner:

B-6 Set Standard Kent County Monument in place of the Iron in mon. box

Set Nail & KC Remon. tag N. side	40" Oak	N80°E	76.40'
Set Nail & KC Remon. tag S. side	36" Oak	N80°W	40.41'
Set Nail & KC Remon. tag W. side	12" Oak	S35°E	90.84'
SW face of yard light		N20°E	110.54'

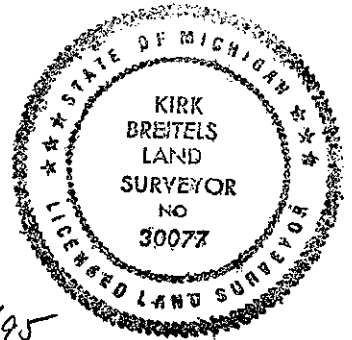

Signed by Kirk Breitels
Surveyor's Michigan License No. 30077

Date 12/14/95