

SURVEY & REMONUMENTATION

KENT COUNTY REMONUMENTATION

APR 28 1995

LAND CORNER RECORDATION CERTIFICATE

Filing Requirement of Act 74, Mich. P.A. 1970

STATE OF MICHIGAN
COUNTY OF KENT
RECEIVED FOR RECORD

94 NOV 28 AM 11:45

For corners in **COMMISSION**
KENT COUNTY

(County)	Located In:	Corner Code ##
1. Public Land Survey	T <u>7N</u> R <u>12W</u>	<u>B-7</u>
	T _____ R _____	_____
	T _____ R _____	_____
	T _____ R _____	_____
2. Property Controlling in Section	S _____ T _____ R _____	_____
	S _____ T _____ R _____	_____
3. Miscellaneous Property in Sec.	S _____ T _____ R _____	_____
	S _____ T _____ R _____	_____

W. R. Byl
REG. OF DEEDS

7283

Register of Deeds Stamp & File Number

- 4. Lot No. _____, Recorded Plat _____
- 5. Private Claims _____

	A	B	C	D	E	F	G	H	I	J	K	L	M
2	6	5	4	3	2	1							
3													
4	7	8	9	10	11	12							
5													
6	18	17	16	15	14	13							
7	●												
8	19	20	21	22	23	24							
9													
10	30	29	28	27	26	25							
11													
12	31	32	33	34	35	36							
13													

I, William R. Byl, in a field survey on July 20, 19 94, do hereby certify that under requirements of P.A. 74, Michigan P.A. of 1970, the corner points mentioned in lines 1 and 2 above were in conformance with regulations and rules therofore as required in the current manual of survey instructions of the United States Department of the Interior, Bureau of Land Management or by a decree of a Court of Law and/or that the corner points mentioned in lines 3, 4 and 5 above were in conformance with the rules of the Michigan Board of Land Surveyors or by a Decree of a Court of Law; established, re-established, monumented, re-monumented, recovered, found as expressed below:

NOTE: Not more than 4 corners, all in the same town and range, may be recorded on this certificate.

A. Description of original monument and accessories and/or subsequent restoration:

B-7	1837	GLO	Whitcomb	Set Post
		Kent Co. Wit.		Mon. Box
	1973	LCRC #377	Spencer	1" dia. Iron in Mon. Box
	1977	LCRC #970	McCloskey	Mon. Box
	1981	LCRC #1843	Shangraw	Set Kent County Monument
	1990	LCRC #5510	Starr	Kent County Monument

The position of this corner was previously approved by the Kent County Remonumentation Peer Group, monumented by Carl F. Shangraw on 5/22/81 and was recorded per LCRC #1843

B. Description of corner evidence found and/or method applied in restoring or reestablishing corner:

B-7 Found standard Kent Co. Mon. (Harrison) per witnesses from above LCRC as set by Carl F. Shangraw in place of the 1" Iron in a Mon. Box he found. Said 1" Iron in Mon. Box checks with Kent Co. Wit. and LCRC's #377 & #970.

LCRC #1843		LCRC #5510	
KC Nail & tag P. Pole	N43°W 61.22'	Face Gas Vent	S55°E 78.12'
KC Nail & tag T. Pole	N48°E 61.32'	Nail & KC tag P. Pole	S47°E 75.87'
KC Nail & tag P. Pole	S47°E 76.92'	Nail & KC tag Guy Pole	N55°E 68.46'
Face Gas Vent	S55°E 78.26'	Nail & KC tag Guy Pole	N50°W 64.70'
		Nail & KC tag P. Pole	S40°W 69.25'


On C/L Bit. Rd. N-S-E-W

The selected location is accepted by me and is generally accepted by professional surveyors as the best available evidence of the position of the original corner.

C. Description of monument for corner and accessories established to perpetuate locating the position of the corner:

B-7 Standard Kent County Monument			
Face Gas Vent		S55°E	78.15'
Nail & KC Remon. tag SW side P. Pole		S47°E	75.91'
Nail & KC Remon. tag S. side Guy Pole		N55°E	68.50'
Nail & KC Remon. tag S. side Guy Pole		N50°W	64.74'
Nail & KC Remon. tag SE side P. Pole		S40°W	69.25'
On C/L Bit. Rd. N-S-E-W			

P.A. 345 1990 KENT COUNTY
PEER APPROVED 11/17/94
CHAIRMAN *Harry Huber*

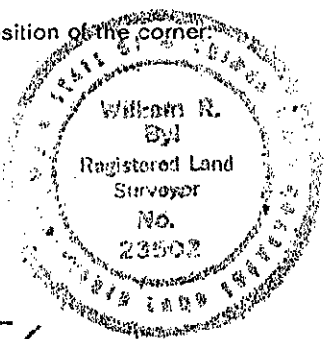

Signed by *W. R. Byl* Date 11-17-94
Surveyor's Michigan License No. 23502