

# SURVEY & REMONUMENTATION

APR 28 1995

## KENT COUNTY REMONUMENTATION LAND CORNER RECORDATION CERTIFICATE Filing Requirement of Act 74, Mich. P.A. 1970

STATE OF MICHIGAN  
COUNTY OF KENT  
RECEIVED FOR RECORD

94 NOV 28 AM 11:45

### COMMISSION

For corners in  
KENT COUNTY  
(County)

Located In:	Corner Code #
T <u>7N</u> R <u>12W</u>	<u>B-13</u>
T _____ R _____	_____
T _____ R _____	_____
T _____ R _____	_____
S _____ T _____ R _____	_____
S _____ T _____ R _____	_____
S _____ T _____ R _____	_____
S _____ T _____ R _____	_____

*W. J. Bond*  
REG. OF DEEDS

7385

Register of Deeds Stamp & File Number

4. Lot No. \_\_\_\_\_, Recorded Plat \_\_\_\_\_  
5. Private Claims \_\_\_\_\_

	A	B	C	D	E	F	G	H	I	J	K	L	M
2	6	5	4	3	2	1							
3													
4	7	8	9	10	11	12							
5													
6	18	17	16	15	14	13							
7													
8	19	20	21	22	23	24							
9													
10	30	29	28	27	26	25							
11													
12	31	32	33	34	35	36							
13													

I, William R. Byl, in a field survey on July 21, 19 94, do hereby certify that under requirements of P.A. 74, Michigan P.A. of 1970, the corner points mentioned in lines 1 and 2 above were in conformance with regulations and rules therefore as required in the current manual of survey instructions of the United States Department of the Interior, Bureau of Land Management or by a decree of a Court of Law and/or that the corner points mentioned in lines 3, 4 and 5 above were in conformance with the rules of the Michigan Board of Land Surveyors or by a Decree of a Court of Law; established, re-established, monumented, re-monumented, recovered, found as expressed below:

**NOTE: Not more than 4 corners, all in the same town and range, may be recorded on this certificate.**

**A. Description of original monument and accessories and/or subsequent restoration:**

Corner Code	Year	Monument	Material	Notes
B-13	1837	GLO	Set Post	Brookfield
		Kent Co. Wit	Iron	
	1977	LCRC #1047	1" Iron	Merdzinski
	1979	LCRC #1300	3/4" Iron	VanLaar
	1982	LCRC #2962	Set Kent County Monument	Merdzinski
	1990	LCRC #5513	Kent County Monument	Starr

P.A. 345 1990 KENT COUNTY

PEER APPROVED 11/17/94

CHAIRMAN *Harry Harper*

The position of this corner was previously approved by the Kent County Remonumentation Peer Group, monumented by John A. Merdzinski on 3/29/82 and was recorded per LCRC #2962

**B. Description of corner evidence found and/or method applied in restoring or reestablishing corner:**


B-13 Found standard Kent Co. Mon. (Harrison) per witnesses from above LCRC as set by John A. Merdzinski in place of the 3/4" Iron over a 5/8" Iron he found. Both Irons check with Kent Co. Wit. & LCRC's #1047 & #1300.

LCRC #2962	LCRC #5513
Nail & KC tag 18" Maple S70°W 54.93'	Nail & KC tag 18" Maple S70°W 54.97'
Nail & KC tag 6" Maple S25°E 40.99'	Nail & KC tag 6" Maple S25°E 40.99'
Nail & KC tag 10" Quad. Maple N80°E 73.75'	Nail & KC tag 10" Qu. Maple N80°E 73.73'
Nail & KC tag 10" Maple S45°W 41.91'	Nail & KC tag 10" Maple S45°W 41.00'
Nail & KC tag 10" Maple N50°W 59.27'	Nail & KC tag 10" Maple N50°W 58.96'
Monument West 48.75'; C/L Rd. 2' S.	Kent Co. Mon. West 48.78'
Corner 300' m/l W. of Wilson Ave.	C/L E-W Grav. Rd. is 2' S.

The selected location is accepted by me and is generally accepted by professional surveyors as the best available evidence of the position of the original corner.

**C. Description of monument for corner and accessories established to perpetuate locating the position of the corner:**

Monument	Material	Notes
B-13 Standard Kent County Monument		
Nail & KC Remon. tag N. side 18" Maple	S70°W 55.01'	
New Nail & KC Remon. tag W. side 6" Maple	S25°E 41.03'	
Nail & KC Remon. tag S. side 10" Quad. Maple	N80°E 73.82'	
Nail & KC Remon. tag NE side 10" Maple	S45°W 41.00'	
Nail & KC Remon. tag E. side 15" Maple	N50°W 59.00'	
Kent Co. Mon.	S90°W 48.78'	
C/L E-W Tar & Stone Rd. is 2' S.		
Corner is 300' m/l W. of Wilson Ave.		

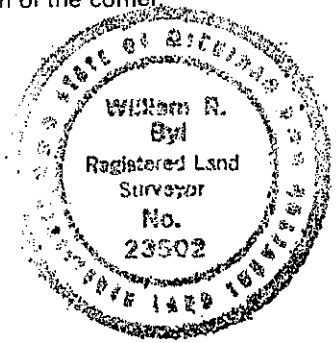

Signed by *W. R. Byl* Date 11-17-94  
Surveyor's Michigan License No. 23502