

# SURVEY & REMONUMENTATION

## KENT COUNTY REMONUMENTATION

APR 28 1995

### LAND CORNER RECORDATION CERTIFICATE Filing Requirement of Act 74, Mich. P.A. 1970

STATE OF MICHIGAN  
COUNTY OF KENT  
RECEIVED FOR RECORD  
94 NOV 28 AM 11:45

For corners in  
**COMMISSION**  
KENT COUNTY  
(County)

Located In: Corner Code #

- |                                    |                          |            |
|------------------------------------|--------------------------|------------|
| 1. Public Land Survey              | T <u>7N</u> R <u>12W</u> | <u>C-1</u> |
|                                    | T _____ R _____          | _____      |
|                                    | T _____ R _____          | _____      |
|                                    | T _____ R _____          | _____      |
| 2. Property Controlling in Section | S _____ T _____ R _____  | _____      |
|                                    | S _____ T _____ R _____  | _____      |
| 3. Miscellaneous Property in Sec.  | S _____ T _____ R _____  | _____      |
|                                    | S _____ T _____ R _____  | _____      |

*Lee J. Bond*  
REG. OF DEEDS

7286

Register of Deeds Stamp & File Number

4. Lot No. \_\_\_\_\_, Recorded Plat \_\_\_\_\_  
5. Private Claims \_\_\_\_\_

	A	B	C	D	E	F	G	H	I	J	K	L	M
2	6	5	4	3	2	1							
3													
4	7	8	9	10	11	12							
5													
6	18	17	16	15	14	13							
7													
8	19	20	21	22	23	24							
9													
10	30	29	28	27	26	25							
11													
12	31	32	33	34	35	36							
13													

I, William R. Byl, in a field survey on July 1, 19 94, do hereby certify that under requirements of P.A. 74, Michigan P.A. of 1970, the corner points mentioned in lines 1 and 2 above were in conformance with regulations and rules therefore as required in the current manual of survey instructions of the United States Department of the Interior, Bureau of Land Management or by a decree of a Court of Law and/or that the corner points mentioned in lines 3, 4 and 5 above were in conformance with the rules of the Michigan Board of Land Surveyors or by a Decree of a Court of Law; established, re-established, monumented, re-monumented, recovered, found as expressed below:

**NOTE: Not more than 4 corners, all in the same town and range, may be recorded on this certificate.**

A. Description of original monument and accessories and/or subsequent restoration:

C-1	1837	GLO	Brookfield	Set Post
	1945-1976	Williams & Works		Iron 99.3' W. of C-13, T8N, R12W
	1963	Kent Co. Wit.		Iron
	1975	LCRC #804	Ruszala	3/4" Iron
	1984	LCRC #3860	Kolehouse	Set Kent County Monument

The position of this corner was previously approved by the Kent County Remonumentation Peer Group, monumented by Randy J. Kolehouse on 5/21/84 and was recorded per LCRC #3860

B. Description of corner evidence found and/or method applied in restoring or reestablishing corner:

C-1 Found standard Kent Co. Mon. (Harrison) per witnesses from above LCRC as set by Randy J. Kolehouse in place of the Iron he found. Said Iron checks with Williams & Works information, Kent Co. Wit. and LCRC #804.


LCRC #3860

Nail & KC Remon. tag W. side P. Pole	N10°E	30.89'
Nail & KC Remon. tag W. side P. Pole	South	60.18'
Nail & KC Remon. tag N. side Tri. 12" Oak	S55°W	63.78'
Nail & KC Remon. tag top of guard rail post	S45°E	42.35'
KC Monument at SE cor. Sec. 31, T8N, R12W	East	99.3'

The selected location is accepted by me and is generally accepted by professional surveyors as the best available evidence of the position of the original corner.

C. Description of monument for corner and accessories established to perpetuate locating the position of the corner:

C-1 Standard Kent County Monument		
Nail & KC Remon. tag W. side P. Pole	N10°E	30.86'
Nail & KC Remon. tag W. side P. Pole	S00°E	60.20'
New Nail & KC Remon. tag N. side Tri. 16" Oak	S55°W	63.70'
Nail & KC Remon. tag top of guard rail post	S45°E	42.38'
Set Nail & KC Remon. tag top of guard rail post	N60°E	48.61'
KC Monument at SE cor. Sec. 31, T8N, R12W	S90°E	99.26'

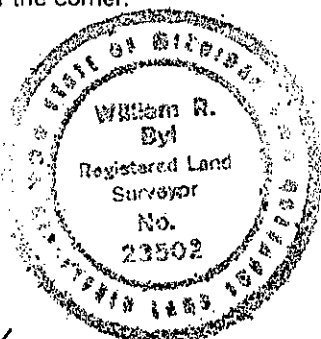

P.A. 345 1900 KENT COUNTY

PEER APPROVED 11/17/94

CHAIRMAN Randy Kolehouse

Date 11-17-94

Signed by William R. Byl

Surveyor's Michigan License No. 23502