

SURVEY & REMONUMENTATION

APR 28 1995

COMMISSION

KENT COUNTY REMONUMENTATION

LAND CORNER RECORDATION CERTIFICATE
Filing Requirement of Act 74, Mich. P.A. 1970

STATE OF MICHIGAN
COUNTY OF KENT
RECEIVED FOR RECORD
94 DEC 27 AM 9:04

For corners in
KENT COUNTY
(County)

Located In: Corner Code #


1. Public Land Survey	T	7N	R	12W	C-2
	T		R		
	T		R		
	T		R		
2. Property Controlling in Section	S		T	R	
	S		T	R	
3. Miscellaneous Property in Sec.	S		T	R	
	S		T	R	

Lucy Bond
REG. OF DEEDS

7891

Register of Deeds Stamp & File Number

4. Lot No. _____, Recorded Plat _____
5. Private Claims _____

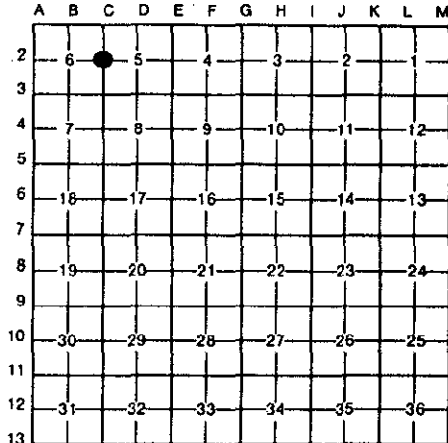

I, William R. Byl, in a field survey on Sept. 7, 19 94

do hereby certify that under requirements of P.A. 74, Michigan P.A. of 1970, the corner points mentioned in lines 1 and 2 above were in conformance with regulations and rules therefore as required in the current manual of survey instructions of the United States Department of the Interior, Bureau of Land Management or by a decree of a Court of Law and/or that the corner points mentioned in lines 3, 4 and 5 above were in conformance with the rules of the Michigan Board of Land Surveyors or by a Decree of a Court of Law; established, re-established, monumented, re-monumented, recovered, found as expressed below:

NOTE: Not more than 4 corners, all in the same town and range, may be recorded on this certificate.

A. Description of original monument and accessories and/or subsequent restoration:

C-2	1837	GLO	Whitcomb	Set Post
	1960	Kent Co. Wit.		1/2" Iron
	1978	LCR #1149	Bonnema	1/2" Iron
	1982	LCRC #2964	Merdzinski	Set Kent County Monument
	1990	LCRC #5514	Starr	Kent County Monument

P.A. 345 1990 KENT COUNTY

PEER APPROVED 12/22/94
CHAIRMAN *Harry Huber*

The position of this corner was previously approved by the Kent County Remonumentation Peer Group, monumented by John A. Merdzinski on 3/29/82 and was recorded per LCRC #2964

B. Description of corner evidence found and/or method applied in restoring or reestablishing corner:

C-2 Found standard Kent Co. Mon. (Harrison) per witnesses from above LCRC as set by John A. Merdzinski in place of the 1/2" Iron he found. Said Iron checks with Kent Co. Wit. and LCRC #1149.

LCRC #2964

LCRC #5514

Nail & tag Tw. 10" Maple	N40°E	16.62'	Nail & tag N. side Tw. 10" Maple	N40°E	16.62'
Nail & tag 18" W. Cherry	N80°E	10.33'	Nail & tag S. side 18" W. Cherry	N80°E	10.33'
Nail & tag 10" Ash	N25°W	24.87'	Nail & tag E. side 10" Ash	N25°W	24.87'
Nail & tag 10" Ash	S30°E	9.86'	Nail & tag S. side 6" Tri-Maple	S55°W	7.11'
Nail & tag 8" Ash	N85°W	15.71'	Nail & tag S. side 8" Ash	N85°W	15.71'

C/L fence N. & treeline S. is 11' E.
C/L RR is 200' m/l N.; N. edge pond is 15' S.


The selected location is accepted by me and is generally accepted by professional surveyors as the best available evidence of the position of the original corner.

C. Description of monument for corner and accessories established to perpetuate locating the position of the corner:

C-2 Standard Kent County Monument

New Nail & KC Remon. tag N. side Tw. 10" Maple	N40°E	16.62'
Nail & KC Remon. tag S. side 20" W. Cherry	N80°E	10.35'
New Nail & KC Remon. tag E. side 12" Ash	N25°W	24.80'
Nail & KC Remon. tag S. side 6" Ash	S55°W	7.11'

C/L fence N. & treeline S. are 11' E.
C/L RR is 200' m/l N.; N. edge pond is 15' S.

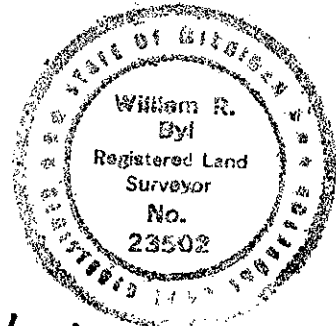

Signed by *William R. Byl*
Surveyor's Michigan License No. 23502

Date 12/07/94