

# SURVEY & REMONUMENTATION

KENT COUNTY REMONUMENTATION

APR 28 1995

## LAND CORNER RECORDATION CERTIFICATE Filing Requirement of Act 74, Mich. P.A. 1970

STATE OF MICHIGAN  
COUNTY OF KENT  
RECEIVED FOR RECORD  
94 NOV 28 AM 11:45

For corners in **COMMISSION**  
KENT COUNTY

(County)	Located In:	Corner Code #
1. Public Land Survey	T <u>7N</u> R <u>12W</u>	<u>C-6</u>
	T _____ R _____	_____
	T _____ R _____	_____
	T _____ R _____	_____
2. Property Controlling in Section	S _____ T _____ R _____	_____
	S _____ T _____ R _____	_____
3. Miscellaneous Property in Sec.	S _____ T _____ R _____	_____
	S _____ T _____ R _____	_____

*Lucy Bond*  
REG. OF DEEDS

7290

Register of Deeds Stamp & File Number

4. Lot No. \_\_\_\_\_, Recorded Plat \_\_\_\_\_  
5. Private Claims \_\_\_\_\_

	A	B	C	D	E	F	G	H	I	J	K	L	M
2	6		5		4		3		2		1		
3													
4	7		8		9		10		11		12		
5													
6	13		17		16		15		14		13		
7													
8	19		20		21		22		23		24		
9													
10	30		29		28		27		26		25		
11													
12	31		32		33		34		35		36		
13													

I, William R. Byl, in a field survey on July 5, 1994, do hereby certify that under requirements of P.A. 74, Michigan P.A. of 1970, the corner points mentioned in lines 1 and 2 above were in conformance with regulations and rules therefore as required in the current manual of survey instructions of the United States Department of the Interior, Bureau of Land Management or by a decree of a Court of Law and/or that the corner points mentioned in lines 3, 4 and 5 above were in conformance with the rules of the Michigan Board of Land Surveyors or by a Decree of a Court of Law; established, re-established, monumented, re-monumented, recovered, found as expressed below:

**NOTE: Not more than 4 corners, all in the same town and range, may be recorded on this certificate.**

**A. Description of original monument and accessories and/or subsequent restoration:**

C-6	1837	GLO	Whitcomb	Set Post
		Kent Co. Wit.		Monument & Iron
	1972	LCRC #112	Bonnema	Boat Spike
	1981	LCRC #1846	Shangraw	Set Kent County Monument
	1990	LCRC #5518	Starr	Kent County Monument

P.A. 315 1950 KENT COUNTY  
PEER APPROVED 11/17/94  
CHAIRMAN *Harry Thibodeau*

The position of this corner was previously approved by the Kent County Remonumentation Peer Group, monumented by Carl F. Shangraw on 5/21/81 and was recorded per LCRC #1846

**B. Description of corner evidence found and/or method applied in restoring or reestablishing corner:**


C-6 Found standard Kent Co. Mon. (Harrison) per witnesses from above LCRC as set by Carl F. Shangraw in place of the Capped Rod (#20881) in Mon. Box he found. Said Capped Iron in Mon. Box checks with Kent Co. Wit. & LCRC #112

<u>LCRC #1846</u>	<u>LCRC #5518</u>
KC Nail & tag Tri. 22" Black Oak West 49.32'	Nail & KC Remon. tag Tri. 22" Black Oak West 49.32'
KC Nail & tag 28" Maple N88°E 28.02'	Nail & KC Remon. tag 28" Maple N88°E 28.04'
KC Nail & tag 14" Hickory N40°E 51.14'	Nail & KC Remon. tag 14" Hickory N40°E 51.15'
	Nail & KC Remon. tag P. Pole S80°E 20.08'
	On C/L N-S Bit. Rd.; On tree line E-W

The selected location is accepted by me and is generally accepted by professional surveyors as the best available evidence of the position of the original corner.

**C. Description of monument for corner and accessories established to perpetuate locating the position of the corner:**

C-6 Standard Kent County Monument			
New Nail & KC Remon. tag S. side Tri. 22" Black Oak	S90°W	48.97'	
Nail & KC Remon. tag NW side 14" Hickory	N40°E	51.15'	
Nail & KC Remon. tag S. side P. Pole	S80°E	20.11'	
Set Nail & KC Remon. tag E. side P. Pole	S25°W	112.87'	
On C/L N-S Bit. Rd.; On tree line E-W			

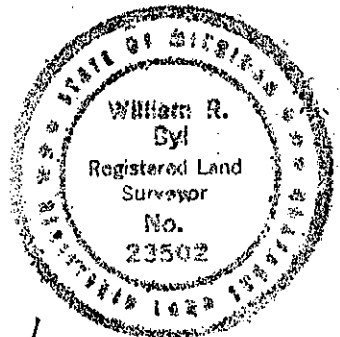

Signed by *William R. Byl* Date 11-17-94  
Surveyor's Michigan License No. 23502