

7
1/2
SURVEY & REMONUMENTATION

APR 28 1995

KENT COUNTY REMONUMENTATION

COMMISSION

LAND CORNER RECORDATION CERTIFICATE
Filing Requirement of Act 74, Mich. P.A. 1970

STATE OF MICHIGAN
COUNTY OF KENT
RECEIVED FOR RECORD
94 NOV 28 AM 11:45

For corners in
KENT COUNTY
(County)


Located In:	Corner Code-#
T 7N R 12W	C-9
T R	
T R	
T R	
S T R	
S T R	
S T R	
S T R	

Luigi Bondi
REG. OF DEEDS

7293

Register of Deeds Stamp & File Number

- Public Land Survey
- Property Controlling in Section
- Miscellaneous Property in Sec.
- Lot No. _____, Recorded Plat _____
- Private Claims _____

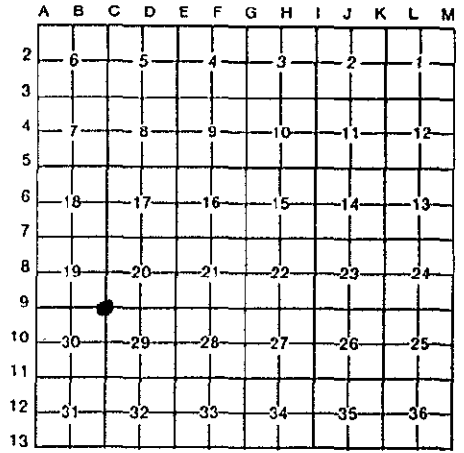

I, William R. Byl, in a field survey on July 21, 19 94, do hereby certify that under requirements of P.A. 74, Michigan P.A. of 1970, the corner points mentioned in lines 1 and 2 above were in conformance with regulations and rules therefore as required in the current manual of survey instructions of the United States Department of the Interior, Bureau of Land Management or by a decree of a Court of Law and/or that the corner points mentioned in lines 3, 4 and 5 above were in conformance with the rules of the Michigan Board of Land Surveyors or by a Decree of a Court of Law; established, re-established, monumented, re-monumented, recovered, found as expressed below:

NOTE: Not more than 4 corners, all in the same town and range, may be recorded on this certificate.

A. Description of original monument and accessories and/or subsequent restoration:

C-9	1837	GLO	Whitcomb	Set Post
		Kent Co. Wit.		Mon. Box
	1974	LCRC #665	Spicer	Iron in Mon. Box
	1975	LCRC #872	Nederveld	Iron in Mon. Box
	1981	LCRC #2041	Hackbardt	Set Kent County Monument
	1990	LCRC #5521	Starr	Kent County Monument

P.A. 345 1990 KENT COUNTY
PEER APPROVED 11/17/94
CHAIRMAN *Harry Huber*

The position of this corner was previously approved by the Kent County Remonumentation Peer Group, monumented by Glen S. Hackbardt on 8/27/81 and was recorded per LCRC #2041

B. Description of corner evidence found and/or method applied in restoring or reestablishing corner:

C-9 Found standard Kent Co. Mon. (Harrison) per witnesses from above LCRC as set by Glen S. Hackbardt in place of the 1/2" Iron in Mon. Box he found. Said 1/2" Iron in Mon. Box checks with Keny Co. Wit. and LCRC's #665 & #872.


LCRC #2041		LCRC #5521	
C/L Manhole	N45°E 42.79'	C/L Manhole	N45°E 42.79'
C/L Manhole	N10°E 38.90'	C/L Manhole	N10°E 38.90'
C/L Manhole	S10°E 51.00'	C/L Manhole	S10°E 51.00'
KC Nail & tag CP Pole	S60°E 58.96'	Nail & KC tag CP Pole	S60°E 58.96'
KC Nail & tag CP Pole	S65°W 60.88'	Nail & KC tag CP Pole	S65°W 60.88'

On C/L Bit. Rd. N-S-E-W

The selected location is accepted by me and is generally accepted by professional surveyors as the best available evidence of the position of the original corner.

C. Description of monument for corner and accessories established to perpetuate locating the position of the corner:

C-9 Standard Kent County Monument	
C/L Manhole (different location)	N45°E 54.15'
C/L Manhole	N10°E 38.90'
C/L Manhole	S10°E 51.00'
PK Nail & KC Remon. tag NE side P. Pole (new)	S60°E 63.86'
PK Nail & KC Remon. tag SE side P. Pole (new)	S65°W 67.31'
NE cor. brick column	S35°W 114.51'
On C/L Bit. Rd. N-S-E-W	

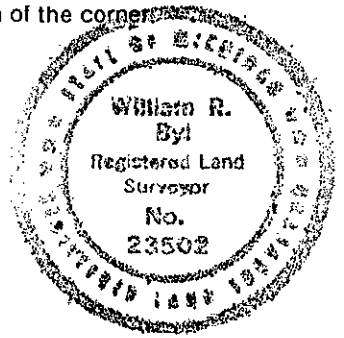

Signed by *W. R. Byl* Date 11-17-94

Surveyor's Michigan License No. 23502