

# SURVEY & REMONUMENTATION

APR 28 1995

KENT COUNTY REMONUMENTATION

LAND CORNER RECORDATION CERTIFICATE  
Filing Requirement of Act 74, Mich. P.A. 1970

STATE OF MICHIGAN  
COUNTY OF KENT  
RECEIVED FOR RECORD

94 NOV 28 AM 11:46

COMMISSION

For corners in  
KENT COUNTY  
(County)

Located In:

Corner Code --#

- |                                       |                          |       |
|---------------------------------------|--------------------------|-------|
| 1. Public Land Survey                 | T <u>7N</u> R <u>12W</u> | D-1   |
|                                       | T _____ R _____          | _____ |
|                                       | T _____ R _____          | _____ |
|                                       | T _____ R _____          | _____ |
| 2. Property Controlling in Section    | S _____ T _____ R _____  | _____ |
|                                       | S _____ T _____ R _____  | _____ |
| 3. Miscellaneous Property in Sec.     | S _____ T _____ R _____  | _____ |
|                                       | S _____ T _____ R _____  | _____ |
| 4. Lot No. _____, Recorded Plat _____ |                          |       |
| 5. Private Claims _____               |                          |       |

*Lucy Bond*  
REG. OF DEEDS

7297

Register of Deeds Stamp & File Number

	A	B	C	D	E	F	G	H	I	J	K	L	M
2	6		5	4	3	2	1						
3													
4	7		8	9	10	11	12						
5													
6	13		17	16	15	14	13						
7													
8	19		20	21	22	23	24						
9													
10	30		29	28	27	26	25						
11													
12	31		32	33	34	35	36						
13													

I, William R. Byl, in a field survey on July 5, 1994, do hereby certify that under requirements of P.A. 74, Michigan P.A. of 1970, the corner points mentioned in lines 1 and 2 above were in conformance with regulations and rules therefore as required in the current manual of survey instructions of the United States Department of the Interior, Bureau of Land Management or by a decree of a Court of Law and/or that the corner points mentioned in lines 3, 4 and 5 above were in conformance with the rules of the Michigan Board of Land Surveyors or by a Decree of a Court of Law; established, re-established, monumented, re-monumented, recovered, found as expressed below:

**NOTE: Not more than 4 corners, all in the same town and range, may be recorded on this certificate.**

A. Description of original monument and accessories and/or subsequent restoration:

D-1	1837	GLO		Not Set
	1940's	Williams & Works		Cor. is 74.00' W. of D-13, T8N, R12W
	1952	Kent Co. Wit.		Iron
	1971	LCRC #65	Spicer	1" Iron
	1984	LCRC #3861	Kolehouse	Set Kent County Monument

The position of this corner was previously approved by the Kent County Remonumentation Peer Group, monumented by Randy J. Kolehouse on 5/21/84 and was recorded per LCRC #3861

B. Description of corner evidence found and/or method applied in restoring or reestablishing corner:

D-1 Found standard Kent Co. Mon. (Harrison) per witnesses from above LCRC as set by Randy J. Kolehouse in place of the Iron he found. Said Iron checks with Kent Co. Wit. and LCRC #65.

LCRC #3861


Nail & KC Remon. tag NW side 16" Pine	S65°W	80.59'	P.A. 345 1990 KENT COUNTY
Nail & KC Remon. tag W. side 24" Pine	S35°W	75.95'	PEER APPROVED 11/17/94
Nail & KC Remon. tag NW face 12" Pine	S50°E	38.57'	CHAIRMAN <i>Randy Kolehouse</i>
Nail & KC Remon. tag SW side P. Pole	N45°W	31.56'	
KC Monument at S 1/4 Sec. 32, T8N, R12W East		74.0'	

The selected location is accepted by me and is generally accepted by professional surveyors as the best available evidence of the position of the corner.

C. Description of monument for corner and accessories established to perpetuate locating the position of the corner:

D-1 Standard Kent County Monument

New Nail & KC Remon. tag NW side 24" Pine	S65°W	80.64'
New Nail & KC Remon. tag W. side 30" Pine	S35°W	76.42'
New Nail & KC Remon. tag NW face 15" Pine	S50°E	38.44'
Nail & KC Remon. tag SW side Tele. Pole	N45°W	31.51'
KC Monument at S 1/4 Sec. 32, T8N, R12W	S90°E	73.93'

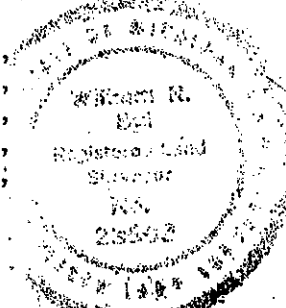

Signed by *W R Byl* Date 11-17-94

Surveyor's Michigan License No. *23553*