SURVEY & REMONUMENTATION

APR 28 1995

COMMISSION

KENT COUNTY REMONUMENTATION

LAND CORNER RECORDATION CERTIFICATE

Filing Requirement of Act 74, Mich. P.A. 1970

STATE OF MICHIGAN
COUNTY OF KENT
RECEIVED FOR RECORD
94 NOV 28 AM 11:46

REG. OF DEEDS

7301

Register of Deeds Stamp & File Number

For corners in KENT COUNTY (County)

	Located In:	Corner Code #
1. Public Land Survey	T 7N R 12W	D-9
	T ___ R ___	
	T ___ R ___	
	T ___ R ___	
2. Property Controlling	S ___ T ___ R ___	
in Section	S ___ T ___ R ___	
3. Miscellaneous	S ___ T ___ R ___	
Property in Sec.	S ___ T ___ R ___	

4. Lot No. _____, Recorded Plat _____
5. Private Claims _____

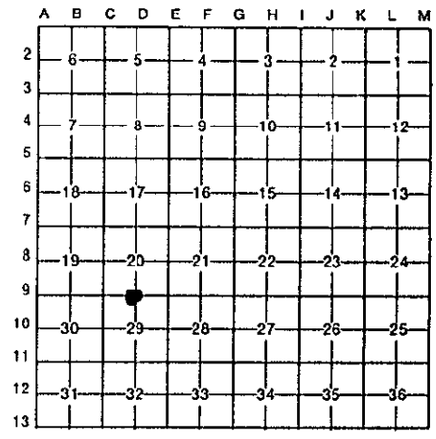

I, William R. Byl, in a field survey on July 22, 19 94, do hereby certify that under requirements of P.A. 74, Michigan P.A. of 1970, the corner points mentioned in lines 1 and 2 above were in conformance with regulations and rules therefore as required in the current manual of survey instructions of the United States Department of the Interior, Bureau of Land Management or by a decree of a Court of Law and/or that the corner points mentioned in lines 3, 4 and 5 above were in conformance with the rules of the Michigan Board of Land Surveyors or by a Decree of a Court of Law; established, re-established, monumented, re-monumented, recovered, found as expressed below:

NOTE: Not more than 4 corners, all in the same town and range, may be recorded on this certificate.

A. Description of original monument and accessories and/or subsequent restoration:

D-9	1837	GLO	Whitcomb	Set Post
	1974	LCRC #684	Bonnema	1/2" Iron in Mon. Box
	1981	LCRC #2041	Hackbardt	Set Kent County Monument
	1990	LCRC #5529	Starr	Kent County Monument

The position of this corner was previously approved by the Kent County Remonumentation Peer Group, monumented by Glen S. Hackbardt on 6/8/81 and was recorded per LCRC #2041

B. Description of corner evidence found and/or method applied in restoring or reestablishing corner:

D-9 Found standard Kent Co. Mon. (Harrison) per witnesses from above LCRC as set by Glen S. Hackbardt in place of the 1/2" Iron in Mon. Box he found. Said 1/2" Iron in Mon. Box checks with LCRC #684 and previous survey information by others.

LCRC #2041			LCRC #5529		
KC Nail & tag Oak	N05°E	69.58'	Nail & KC Remon. tag Oak	N05°E	65.58'
C/L Manhole	S10°E	35.35'	C/L Manhole	S10°E	35.35'
C/L Manhole	S05°W	57.5'	NE corner house fdn.	S35°W	133.65'
NE cor. hse. fdn.	S35°W	133.65'	Nail & KC Remon. tag 26" Maple	S20°E	110.02'
KC Nail & tag 26" Maple	S20°E	110.02'	Nail & KC Remon. tag Guy Pole	N35°E	47.20'
			C/L E-W Bit. Rd. is 1' N,; On C/L Bit. Rd. S.		

The selected location is accepted by me and is generally accepted by professional surveyors as the best available evidence of the position of the original corner.

C. Description of monument for corner and accessories established to perpetuate locating the position of the corner:

D-9 Standard Kent County Monument

New Nail & KC Remon. tag W. side 48" Oak	N05°E	65.56'
C/L Manhole	S10°E	35.35'
NE corner house fdn.	S35°W	133.65'
Nail & KC Remon. tag W. side Guy Pole	N35°E	47.23'
Top C/L W. end fence post	S35°E	61.58'

C/L E-W Bit. Rd. is 1' N,; On C/L Bit. Rd. S.

P.A. 345 1990 KENT COUNTY
PEER APPROVED 11/17/94
CHAIRMAN

William R. Byl
Registered Land Surveyor
No. 23502

Signed by _____ Date 11-17-94

Surveyor's Michigan License No. 23502

FORM APPROVED BY MICHIGAN STATE BOARD OF LAND SURVEYORS, JAN. 28, 1971
REVISED MAY 14, 1975
REVISED JAN., 1983